

MAR 17 2000

FILED

SECTION

LAND CORNER RECORDATION CERTIFICATE
Filing Requirement of Act 74, Mich. P.A. 1970

1999 NOV 22 A 11:07

For corners in
LIVINGSTON
(County)

Located in: GENOA Corner Code # 9

NANCY HAVILAND
REGISTER OF DEEDS
LIVINGSTON COUNTY, MI.
48843

1. Public Land Survey	T <u>2N</u> R <u>5E</u>	G-10
	T _____ R _____	_____
	T _____ R _____	_____
	T _____ R _____	_____
2. Property Controlling in Section	S _____ T _____ R _____	_____
	S _____ T _____ R _____	_____
3. Miscellaneous Property in Section	S _____ T _____ R _____	_____
	S _____ T _____ R _____	_____

LSC# 1105m

Register of Deeds Stamp and File Number

4. Lot No. _____, Recorded Plat _____
5. Private Claims _____

A	B	C	D	E	F	G	H	I	J	K	L	M
2	6	5	4	3	2	1						
3												
4	7	8	9	10	11	12						
5												
6	18	17	16	15	14	13						
7												
8	19	20	21	22	23	24						
9												
10	30	29	28	27	26	25						
11												
12	31	32	33	34	35	36						
13												

I, Bryan L. Boss, in a field survey on AUG. 31, 1999, do hereby certify that under requirements of P.A. 74, Michigan P.A. of 1970, the corner points mentioned in lines 1 and 2 above were in conformance with regulations and rules therefor as required in the current manual of survey instructions of the United States Department of the Interior, Bureau of Land Management or by a decree of a Court of Law and/or that the corner points mentioned in lines 3, 4 and 5 above were in conformance with the rules of the Michigan Board of Land Surveyors or by a Decree of a Court of Law; established, re-established, monumented, re-monumented, recovered, found as expressed below.

NOTE: Not more than 4 corners, all in the same town and range, may be recorded on this certificate.

A. Description of original monument and accessories and/or subsequent restoration:

SET POST
14" W. OAK N45°1/2°E 28 LINKS (18.48')
12" B. OAK S40°1/2°W 19 LINKS (12.54')


B. Description of corner evidence found and/or method applied in restoring or reestablishing corner:

FOUND 1/2" IRON ROD AT THE EASTERLY EDGE OF ASPHALT (CLUB HOUSE DRIVE)

C. Description of monument for corner and accessories established to perpetuate locating the position of the corner:

SET 1 1/4" X 30" PIPE WITH A PLASTIC INSERT
CONNECTED TO A 1 1/4" X 36" PIPE WITH A
BRASS CAP STAMPED "LIVINGSTON COUNTY
REMONUMENTATION CORNER" IN A MONUMENT
BOX SET IN AN ASPHALT ROAD
S 80°E 54.37' SET REMON NAIL & TAG N/SIDE 30" OAK
S 70°E 20.89' SET REMON NAIL & TAG SW/SIDE 20" HICKORY
S 30°E 16.62' SET REMON NAIL & TAG NE/SIDE 30" OAK
N 30°W 81.34 SET REMON NAIL & TAG NE/SIDE 22" OAK

P.A. 345 1990, APPROVED BY LIVINGSTON COUNTY
PLER GROUP ON 6-16-99 CO. REP JED

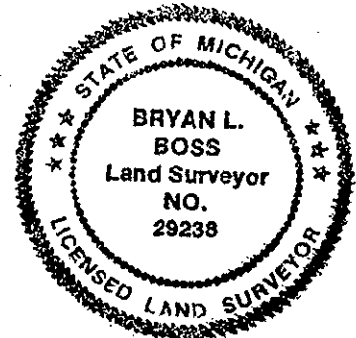

Signed by [Signature] Date NOV. 9, 1999
Surveyor's Michigan License No. 29238