

FEB 25 1999

SECTION

LAND CORNER RECORDATION CERTIFICATE
Filing Requirement of Act 74, Mich. P.A. 1970

FILED

For corners in

Livingston County Located In: Corner Code //

1. Public Land Survey T 2N R 5E G-11
T _____ R _____
T _____ R _____
T _____ R _____

2. Property Controlling S _____ T _____ R _____
in Section S _____ T _____ R _____

3. Miscellaneous S _____ T _____ R _____
Property in Sec. S _____ T _____ R _____

4. Lot No. _____, Recorded Plat _____

5. Private Claims _____

1998 OCT 22 P 1:18

NANCY HAVILAND
REGISTER OF DEEDS
LIVINGSTON COUNTY, MI.
48843

LSC958M

Register of Deeds Stamp & File Number

Bryan L. Boss, in a field survey on Oct. 8, 1998, do hereby certify that under requirements of P.A. 74, Michigan P.A. of 1970, the corner points mentioned in lines 1 and 2 above were in conformance with regulations and rules therefore as required in the current manual of survey instructions of the United States Department of the Interior, Bureau of Land Management or by a decree of a Court of Law and/or that the corner points mentioned in lines 3, 4 and 5 above were in conformance with the rules of the Michigan Board of Land Surveyors or by a Decree of a Court of Law; established, re-established, monumented, re-monumented, recovered, found as expressed below:

NOTE: Not more than 4 corners, all in the same town and range, may be recorded on this certificate.

| A | B | C | D | E | F | G | H | I | J | K | L | M |
|----|----|----|----|----|----|----|---|---|---|---|---|---|
| 2 | 6 | 5 | 4 | 3 | 2 | | | | | | | |
| 3 | | | | | | | | | | | | |
| 4 | 7 | 8 | 9 | 10 | 11 | 12 | | | | | | |
| 5 | | | | | | | | | | | | |
| 6 | 18 | 17 | 16 | 15 | 14 | 13 | | | | | | |
| 7 | | | | | | | | | | | | |
| 8 | 19 | 20 | 21 | 22 | 23 | 24 | | | | | | |
| 9 | | | | | | | | | | | | |
| 10 | 30 | 29 | 28 | 27 | 26 | 25 | | | | | | |
| 11 | | | | | | | | | | | | |
| 12 | 31 | 32 | 33 | 34 | 35 | 36 | | | | | | |
| 13 | | | | | | | | | | | | |

A. Description of original monument and accessories and/or subsequent restoration:

Corner set in 1823 by S. Sibley Deputy Surveyor, set post
Black Oak 10" N 33 W 8 links
Black Oak 10" N 14 E 14 Links


3. Description of corner evidence found and/or method applied in restoring or reestablishing corner:

Found 1/2" iron rod in mon. box 1 Centerline Brighton Road

PA 345 1990, APPROVED BY LIVINGSTON COUNTY
PEER GROUP ON 9-2-98, CO. REP. WED

2. Description of monument for corner and accessories established to perpetuate locating the position of the corner:

Set 1 1/4" by 30" iron pipe with Brass cap stamped "Livingston
County Monumentation Corner"
N 81 E 157.82 set Remon N/T on top Guard Rail post
S 68 E 60.01 set Remon N/T on top of Guard Rail post
S 13 E 24.33 set Remon N/T on top of Guard Rail post
S 28 W 26.80 set Remon N/T on top of Guard Rail post

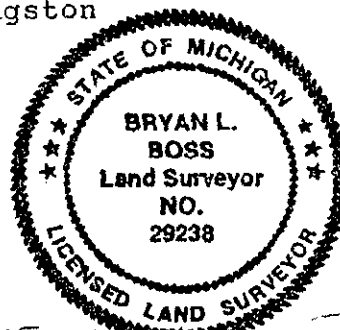

Signed by [Signature]
Surveyor's Michigan License No. 29238

Date 10-15-1998