

SURVEY & REMONUMENTATION

FEB 24 1998

SECTION

LAND CORNER RECORDATION CERTIFICATE

Filing Requirement of Act 74, Mich. P.A. 1970

9- FILED

For corners in

LIVINGSTON
(County)

Located In:

Corner Code #/

GENOA TWP.

T 2N R 5E

G-13

T R

T R

T R

S T R

S T R

S T R

S T R

1. Public Land Survey

2. Property Controlling in Section

3. Miscellaneous Property in Sec.

4. Lot No. , Recorded Plat

5. Private Claims

1997 NOV 25 A 11:13

NANCY HAVILAND
REGISTER OF DEEDS
LIVINGSTON COUNTY, MI.
48843

L.S.C.#821m

Register of Deeds Stamp & File Number

	A	B	C	D	E	F	G	H	I	J	K	L	M
2	6		5		4		3		2		1		
3													
4	7		8		9		10		11		12		
5													
6	18		17		16		15		14		13		
7													
8	19		20		21		22		23		24		
9													
10	30		29		28		27		26		25		
11													
12	31		32		33		34		35		36		
13													

BRYAN L. BOSS, in a field survey on SEPTEMBER 19, 1997

do hereby certify that under requirements of P.A. 74, Michigan P.A. of 1970, the corner points mentioned in lines 1 and 2 above were in conformance with regulations and rules therefore as required in the current manual of survey instructions of the United States Department of the Interior, Bureau of Land Management or by a decree of a Court of Law and/or that the corner points mentioned in lines 3, 4 and 5 above were in conformance with the rules of the Michigan Board of Land Surveyors or by a Decree of a Court of Law; established, re-established, monumented, re-monumented, recovered, found as expressed below:

NOTE: Not more than 4 corners, all in the same town and range, may be recorded on this certificate.

Description of original monument and accessories and/or subsequent restoration:


BLACK OAK 14" N 88 W 2.45 CHAINS NO OTHER TIMBER NEAR.

Description of corner evidence found and/or method applied in restoring or reestablishing corner:

FOUND CONCRETE MONUMENT ON LINE WITH FENCE REMNANTS TO THE NORTH AND ON LINE WITH A FENCE EAST & WEST. REMNANTS OF A FENCE TO THE SOUTH APPROX. SEVEN FEET EASTERLY,

Description of monument for corner and accessories established to perpetuate locating the position of the corner:

SET BRASS CAP STAMPED "LIVINGSTON COUNTY MONUMENTATION CORNER" ON REBAR IN CONCRETE MONUMENT.
NORTH 7.02' NAIL & TAG WEST SIDE RAILROAD TIE
S 75 E 28.48' NAIL & TAG SOUTH SIDE 10" CHERRY
EAST 10.19' 1/2" INCH IRON ROD
N 50 E 102.68' NAIL & TAG SOUTH SIDE 10" PINE TREE

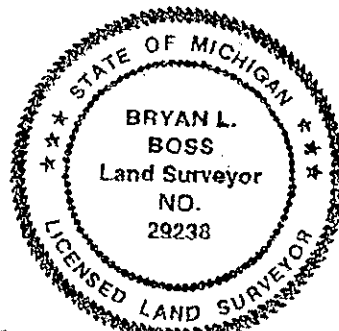

Surveyed by Bryan L. Boss Date Sept. 25, 1997

Surveyor's Michigan License No. 29238

**SUMMARY
G-13**

Southeast Corner, Section 33, Genoa Township.

Original Corner set December 15, 1815.


6-26-80, A.F. Miller found G-1, the Northwest Corner of Section 3, Hamburg Township. The survey on page 10, this dossier, does not record fall in distance to G-13, the controlling corner. The G.L.O. Map calls for 22 links (14.5 feet) fall in distance West of G-13.

Act 74 by Jack Smith (page 11) found 1/2" iron with no apparent evidence of jog to the West. (Confirmed by Boss)

4-30-97 Boss found a conc. mon. that checked the witnesses of the Act 74 by Smith. This conc mon. was on line with a fence remnants to the North and on line with a fence East and West, there are remnants of a fence to the South approx. 7 feet Easterly. On 8-12-97 Boss found a pointed cedar post with only the bottom 1 foot remaining and removed it from peat bog. The location was found to be 2 feet South of existing concrete monument set by Desine.

This Corner was located by using GPS and is open for G.P.S.

We recommend accepting the concrete monument set by Jack Smith to be the original Southeast Corner, Section 33, Genoa Township.

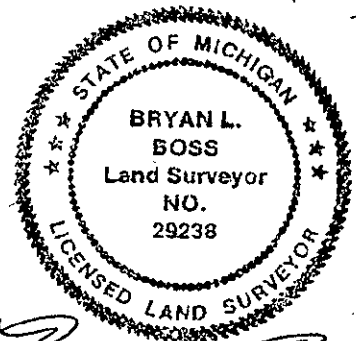

Bryan L. Boss