

9-

LAND CORNER RECORDATION CERTIFICATE
Filing Requirement of Act 74, Mich. P.A. 1970

For Corners in GENOA TWP.

<u>LIVINGSTON</u> (COUNTY)	Located In	Corner Code #
1. Public Land Survey	T <u>2N</u> R <u>5E</u>	<u>1-3</u>
	T___ R___	_____
	T___ R___	_____
	T___ R___	_____
2. Property Controlling in Section	S___ T___ R___	_____
	S___ T___ R___	_____
3. Miscellaneous Property in Sec.	S___ T___ R___	_____
	S___ T___ R___	_____

FILED

1996 DEC 19 A 11:27
NANCY HAVILAND
REGISTER OF DEEDS
LIVINGSTON COUNTY, MI.
48843

L. S. C. #641m
REGISTER OF DEEDS STAMP & FILE NUMBER

4. Lot No. _____, Recorded Plat _____
5. Private Claims _____

	A	B	C	D	E	F	G	H	I	J	K	L	M
2	6	5	4	3	2	1							
3													
4	7	8	9	10	11	12							
5													
6	18	17	16	15	14	13							
7													
8	19	20	21	22	23	24							
9													
10	30	29	28	27	26	25							
11													
12	31	32	33	34	35	36							
13													

I, BRYAN L. BOSS in a field survey on OCTOBER 29, 1996, do hereby certify that under requirements of P.A. 74, Michigan P.A. of 1970, the corner points mentioned in lines 1 and 2 above were in conformance with regulations and rules therefore as required in the current manual of survey instructions of the United States Department of the Interior, bureau of Land Management or by a decree of a Court of Law and/or that the corner points mentioned in lines 3, 4 and 5 above were in conformance with the rules of the Michigan Board of Land Surveyors or by a Decree of a Court of Law, established, re-established, monumented, re-monumented, recovered, found as expressed below:

NOTE: Not more than 4 corners, all in the same town and range, may be recorded on this certificate.

A. Description of original monument and accessories and/or subsequent restoration:

ORIGINAL CORNER SET IN 1837.
WHITE ASH 8" N 8½° W 40 LINKS
IRON WOOD 6" S 11° W 20 LINKS
WHITE ASH 10" S 23½° E 35 LINKS


B. Description of corner evidence found and/or applied in restoring or reestablishing corner:

FOUND ½" REROD AT FENCE POST.
FENCE LINE EASTERLY AND SOUTHERLY FROM CORNER.

C. Description of monument for corner and accessories established to perpetuate location the position of the corner:

SET 1 ¼" X 36" PIPE WITH BRASS CAP STAMPED
"LIVINGSTON COUNTY MONUMENTATION CORNER".

S 70° E NAIL & TAG SOUTH SIDE 18" OAK 14.41'
S 30° E NAIL & TAG NORTH SIDE 26" OAK 21.51'
S 45° W NAIL & TAG NORTHWEST SIDE 18" OAK 32.26'
N 70° W NAIL & TAG SOUTH SIDE 22" OAK 33.34'

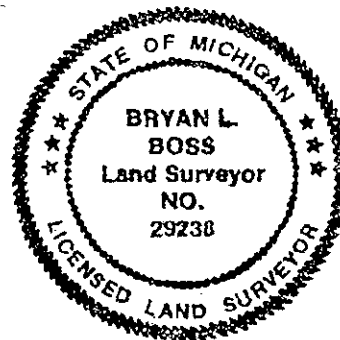

Signed by Bryan L. Boss Date 12-12-1996
Surveyor's Michigan License No. 29238

FORM APPROVED BY MICHIGAN STATE BOARD OF LAND SURVEYORS, JAN. 28, 1971
REVISED MAY 14, 1975
REVISED JAN., 1983

P.A. 345 1990, APPROVED BY LIVINGSTON COUNTY
PEER GROUP ON 9-18-96, CO. REP JED

SUMMARY

I-3

Northwest Corner, Section 11, T2N-R5E, Genoa Township, Livingston County, Michigan

CORNER EVIDENCE

Found 1/2" Iron Rod at fence Line Easterly and Fence Line Southerly
No other point or occupation location in area.
Heavy woods in all directions will make this a very difficult G.P.S. location.

This corner was originally set 1837 and resurveyed by Bullock in 1898.

DISTANCES

Boss survey and Cornerstone surveys are the only surveys in this dossier that measure to this Section Corner . Both surveys use same point.

WITNESSES

1989 Cornerstone survey (page 14) refers to a RLS # 07481-- Bevel Boyd. Unable to find source for this note. Witnesses by Cornerstone and Boss use same 4 witness points and they agree.

RECOMMENDATION

We recommend that the existing 1/2" iron is used as "I-3".



Bryan L. Boss
Bryan L. Boss No. 29238