

OCT 26 1995

COMMISSION LAND CORNER RECORDATION CERTIFICATE  
Filing Requirement of Act 74, Mich. P.A. 1970

For corners in Livingston

County	Located In;	Corner Code
	2N 5E	1-5
1. Public Land Survey	T R	
	T R	
	T R	
	T R	
2. Property Controlling in Section	S T R	
	S T R	
3. Miscellaneous Property in Sec.	S T R	
	S T R	

FILED  
 OCT 6 11 57 AM '95  
 REGISTER OF DEEDS  
 LIVINGSTON COUNTY, MI  
 48845

L.S.C.#476m

Register of Deeds Stamp & File Number

4. Lot No. \_\_\_\_\_, Recorded Plat \_\_\_\_\_  
 5. Private Claims \_\_\_\_\_

	A	B	C	D	E	F	G	H	I	J	K	L	M
2	6	5	4	3	2	1							
3													
4	7	8	9	10	11	12							
5													
6	13	17	16	15	14	13							
7													
8	19	20	21	22	23	24							
9													
10	30	29	28	27	26	25							
11													
12	31	32	33	34	35	36							
13													

I, Bryan Boss, in a field survey on 9-26, 1995, do hereby certify that under requirements of P.A. 74, Michigan P.A. of 1970, the corner points mentioned in lines 1 and 2 above were in conformance with regulations and rules therefore as required in the current manual of survey instructions of the United States Department of the Interior, Bureau of Land Management or by a decree of a Court of Law and/or that the corner points mentioned in lines 3, 4 and 5 above were in conformance with the rules of the Michigan Board of Land Surveyors or by a Decree of a Court of Law; established, re-established, monumented, re-monumented, recovered, found as expressed below:

NOTE: Not more than 4 corners, all in the same town and range, may be recorded on this certificate.

Description of original monument and accessories and/or subsequent restoration:


- Black Oak 10" N 56 1/2 E 1.60
- Black Oak 12" S 41° W 75 Links
- Black Oak 23" S 7 1/4 W 10

Description of corner evidence found and/or method applied in restoring or reestablishing corner:

Railroad spike found 5 1/2 feet ± East of centerline Dorr Road. No occupation.  
 West 4.0' Center Dorr Road  
 West 90.2' Center 15" Elm  
 N 70° W 92.1' SE Corner Bldg.  
 N 45° W 121.7' NE Corner Bldg  
 N 80° E 29.5' Center CP Gas signs

Description of monument for corner and accessories established to perpetuate localing the position of the corner:

Set brass cap on 1/2" iron in monument box  
 90.15' West nail & tag 14" Elm  
 121.74' N 45° W Northeast corner commercial building  
 69.75' N 30° W Signpost  
 236.08' S 20° E 36" Oak

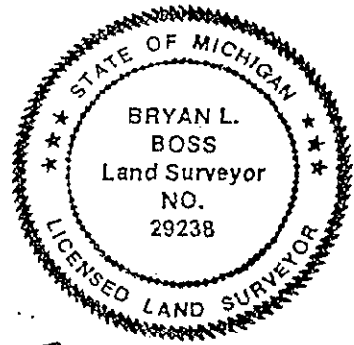

Recorded by [Signature] Date OCT 4, 1995  
 Surveyor's Michigan License No. 29238

SUMMARY

I-5

Northwest Corner, Section 14, T2N-R5E, Genoa Township, Livingston County, Michigan.

This section originally surveyed by Sylvester Sibley in 1823. Corner was again witnessed by Miles Bullock in 1880.

Found railroad spike 5 1/2 feet ± East of the centerline of Dorr road. No occupation East or West. Open field to the East and in the Southwest Quadrant.


Measured to witnesses found. Garlock witnesses pages 11-13-14-18-20-21 are gone. Herb Munzel witnesses page 17 are gone and Boss Engineering witnesses page 26 are gone. Garlock witnesses, page 19-23-24-30 checked within 0.05 hundredths of Boss Engineering witnesses on Page 28.

Distance from the Northwest corner of Section 14 to the South R.O.W. line of Grand River measured 800 feet, pages 10-12-20-21-23-34-30 of this dossier. Surveys southerly to the West 1/4 Corner of said Section 14 show Pat Benton and Boss Engineering are in agreement.

This corner is open for G.P.S.

Conclusion: Recorded witnesses from 1988 to 1993 and consistency of measurement from Northwest Corner of Section 14 to the South right-of-way of Grand River justify acceptance of found railroad spike.

GENI-5S

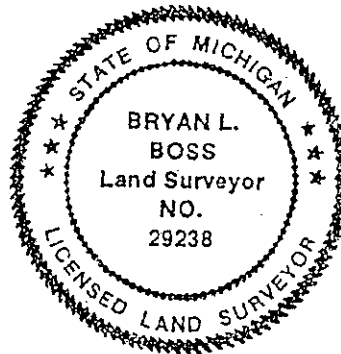

*Bryan L. Boss*