

LAND CORNER RECORDATION CERTIFICATE
Filing Requirement of Act 74, Mich. P.A. 1970

OCT 11 10 29 AM '95
NANCY HAVILAND
REGISTER OF DEEDS
LIVINGSTON COUNTY, MI
48843

FILED

or corners in
Livingston Located In: Corner Code #I-6
(County)
Public Land Survey T 2N R 5E _____
T _____ R _____
T _____ R _____
T _____ R _____
Property Controlling S _____ T _____ R _____
in Section S _____ T _____ R _____
Miscellaneous S _____ T _____ R _____
Property in Sec. S _____ T _____ R _____

L. S. C. #480m
Register of Deeds Stamp & File Number

Lot No. _____, Recorded Plat _____
Private Claims _____

	A	B	C	D	E	F	G	H	I	J	K	L	M
2	6	5	4	3	2	1							
3													
4	7	8	9	10	11	12							
5													
6	18	17	16	15	14	13							
7													
8	19	20	21	22	23	24							
9													
10	30	29	28	27	26	25							
11													
12	31	32	33	34	35	36							
13													

Bryan Boss, in a field survey on 10-4, 19 95,
I hereby certify that under requirements of P.A. 74, Michigan P.A. of 1970, the corner points mentioned
in lines 1 and 2 above were in conformance with regulations and rules therefore as required in the
current manual of survey instructions of the United States Department of the Interior, Bureau of Land
Management or by a decree of a Court of Law and/or that the corner points mentioned in lines 3, 4 and 5
above were in conformance with the rules of the Michigan Board of Land Surveyors or by a Decree of a
Court of Law; established, re-established, monumented, re-monumented, recovered, found as
expressed below:

NOTE: Not more than 4 corners, all in the same town and range, may be recorded
on this certificate.

Description of original monument and accessories and/or subsequent restoration:

- Black Oak 11" N 48 E 43 links
- Black Oak 9" N 46 1/2 W 77 links
- Black Oak 10" S 83 1/2 E 47

Description of corner evidence found and/or method applied in restoring or reestablishing corner:

(Corner Obliterated) Measured Recorded distance Southerly
from I-5 per Patrick Benton job # 78-S-2681. Also measured
recorded distance Easterly from Patrick L. Benton I-96
Right-of-Way iron.
Nail East side telephone pole - S 10° W 147.78 feet
nail East side telephone pole - N 10° W 191.40 feet
bottom center of street sign post - N 23° E 104.57 feet
Found 3/4" iron bar N 35° W 4.20 feet of East 1/2 Corner.


SURVEY &
REMONUMENTATION

NOV 27 1995

COMMISSION

Description of monument for corner and accessories established to perpetuate locating the position of the corner:

- Monument box set with 1/2" rerod and brass cap
- 191.12' N 10° W nail & tag East side power pole
- 145.83' S 10° W nail & tag East side power pole
- 19.68' S 55° E nail & tag top center guard rail post.
- 26.68' N 40° E nail & tag top center guard rail post

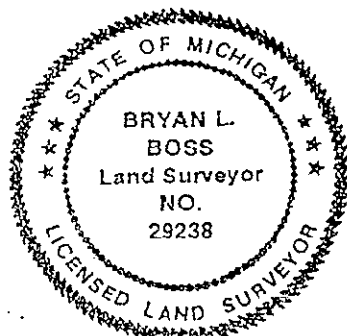

signed by Bryan L. Boss Date Oct. 5, 1995
Surveyor's Michigan License No. 29238

SUMMARY

I-6

West 1/4 Corner, Section 14, T2N-R5E, Genoa Township, Livingston County, Michigan.

G.P.S. is good.

Corner obliterated by reconstruction of bridge approach area. Site distance from Herbst Road intersection with Dorr Road required change in elevation. Set P.K. Nail holding recorded measurement from railroad spike at I-5 and Patrick L. Benton iron found at right-of-way fence for I-96 expressway. (See pages 18 & 6A & 36 this dossier) and existing witnesses.

This point falls approximately 2½' feet East of existing centerline of Dorr Road. Field notes on page 10 denotes railroad spike set 3' feet East of existing centerline.

Only one Witness remains from 12-12-1973 Witnesses on page 14, Boss Engineering survey. Also one Witness from pages 16, 18, 19, 20, 23 & 36.

This P.K. is at location per Act 74, Herb Munzel (page 16).


Act 74 by Herb Munzel (page 16) shows 3/4" iron rod, North Northwest, 4.2 feet from corner I-6. This 3/4" rod in centerline of road appears to be the corner used by M.D.O.T. survey (page 35 & 36) and would explain most of the differences between I-6 & I-7 recorded distances by Benton, Garlock & boss of 2652 feet ± and the M.D.O.T. measurement of 2655 feet ±. The Progressive Engineers measurement (page 33) between I-5 and I-6 appears to use this 3/4" iron rod also.

The M.D.O.T. survey and Progressive survey are the only surveys using 3/4" rod. All others use Act 74 point.

Conclusion:

Recommendation setting West ¼ Corner of Section 14 by acceptance of Boss Engineering traverse and computations from North ¼ Corner to Northwest Corner to West ¼ Corner to Southwest Corner of said Section 14.

GENI-6S

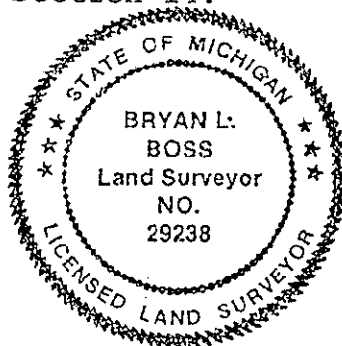

Bryan L. Boss