

OCT 26 1995

**COMMISSION**

**LAND CORNER RECORDATION CERTIFICATE**  
Filing Requirement of Act 74, Mich. P.A. 1970

HARCY HAVILANE  
REGISTER OF DEEDS  
LIVINGSTON COUNTY, MI  
48843

OCT 4 3 20 PM '95

FILED

For corners in

<u>Livingston</u> (County)	Located In:	Corner Code ==
1. Public Land Survey	T <u>2N</u> R <u>5E</u>	<u>I-8</u>
	T _____ R _____	_____
	T _____ R _____	_____
	T _____ R _____	_____
2. Property Controlling in Section	S _____ T _____ R _____	_____
	S _____ T _____ R _____	_____
3. Miscellaneous Property in Sec.	S _____ T _____ R _____	_____
	S _____ T _____ R _____	_____

L.S.C. #457m

Register of Deeds Stamp & File Number

4. Lot No. \_\_\_\_\_, Recorded Plat \_\_\_\_\_  
5. Private Claims \_\_\_\_\_

	A	B	C	D	E	F	G	H	I	J	K	L	M
2	6	5	4	3	2	1							
3													
4	7	8	9	10	11	12							
5													
6	18	17	16	15	14	13							
7													
8	19	20	21	22	23	24							
9													
10	30	29	28	27	26	25							
11													
12	31	32	33	34	35	36							
13													

I, Bryan Boss, in a field survey on 8-24, 19 95, do hereby certify that under requirements of P.A. 74, Michigan P.A. of 1970, the corner points mentioned in lines 1 and 2 above were in conformance with regulations and rules therefore as required in the current manual of survey instructions of the United States Department of the Interior, Bureau of Land Management or by a decree of a Court of Law and/or that the corner points mentioned in lines 3, 4 and 5 above were in conformance with the rules of the Michigan Board of Land Surveyors or by a Decree of a Court of Law; established, re-established, monumented, re-monumented, recovered, found as expressed below:

NOTE: Not more than 4 corners, all in the same town and range, may be recorded on this certificate.

**1. Description of original monument and accessories and/or subsequent restoration:**


- White Oak 24" 576 W 97 links
- Black Oak 18" N 18 1/2 E 1.02 chains
- White Oak 13" N 28 W 59 links

**2. Description of corner evidence found and/or method applied in restoring or reestablishing corner:**

- Found 1/2" iron rod in monument box
- 67.58 West spike South side 15" Walnut
- 47.44 N 45° W spike Northeast side power pole
- 67.47 S 45° E spike Northeast side 4" Elm

**3. Description of monument for corner and accessories established to perpetuate locating the position of the corner:**

- Set brass cap on 1/2" iron in monument box
- East 40.14 nail & tag South side 12" Cherry
- S 65° E 84.77 nail & tag West side 8" Cherry
- N 85° W 67.49 nail & tag South side 18" Walnut
- N 30° W 47.53 nail & tag East side telephone pole

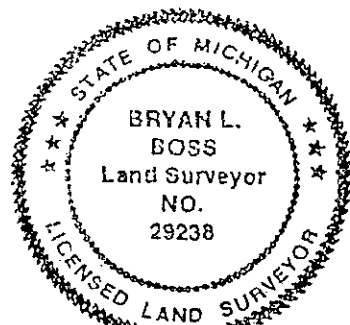

Signed by Bryan L. Boss

Date Sept. 28, 1995

Surveyor's Michigan License No. 29238

SUMMARY

I-8

West 1/4 Corner, Section 23, T2N-R5E, Genoa Township, Livingston County, Michigan.


Found 1/2" iron rod in monument box 1 foot ± West of centerline Dorr Road. No evidence of multiple corner. This corner is open to G.P.S. originally surveyed in 1840. Southwest 1/4 of Section 23 surveyed and split by Miles Bullock in 1880, page 8 this dossier.

Found 18" walnut West 68.0 feet. Field notes from Garlock records of 1953 show same witness, 8" Black Walnut West 68' to centerline, see pages 11-12-14.

On December 5, 1977, Boss Engineering set 1/2" iron, pages 16-17-18 this dossier. On 9-15-80 Darrell Hughes survey, page 20, refers to same 1/2" iron and witnesses.

On 2-1-1985 the Livingston County Road Commission (page 23) re-witnesses this point and set subsequent monument box. Conclusion: We find that the 1/2" iron set by Boss Engineering is in the same location, as found by Munsell in 1953 and recommend it's acceptance as found on 12-30-94.

GENI-8S

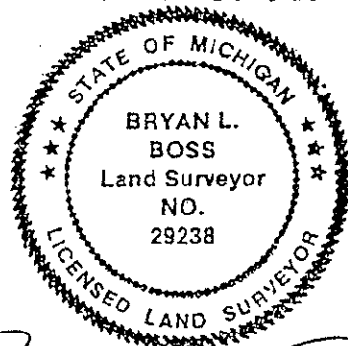

*Bryan L. Boss*