

FILED

DEC 29 11 25 AM '93

LAND CORNER RECORDATION CERTIFICATE

Filing Requirement of Act 74, Mich. P.A. 1970

NANCY HAVILAND
REGISTER OF DEEDS
LIVINGSTON COUNTY, MI
48843

For corners in

Livingston	Located In:	Corner Code #/
1. Public Land Survey	T <u>2N</u> R <u>5E</u>	<u>I-12</u>
	T _____ R _____	_____
	T _____ R _____	_____
	T _____ R _____	_____
2. Property Controlling in Section	S _____ T _____ R _____	_____
	S _____ T _____ R _____	_____
3. Miscellaneous Property in Sec.	S _____ T _____ R _____	_____
	S _____ T _____ R _____	_____

L.S.C. #167m

Register of Deeds Stamp & File Number

4. Lot No. _____, Recorded Plat _____
5. Private Claims _____

I, Bryan Boss, in a field survey on December 22, 1993, do hereby certify that under requirements of P.A. 74, Michigan P.A. of 1970, the corner points mentioned in lines 1 and 2 above were in conformance with regulations and rules therefore as required in the current manual of survey instructions of the United States Department of the Interior, Bureau of Land Management or by a decree of a Court of Law and/or that the corner points mentioned in lines 3, 4 and 5 above were in conformance with the rules of the Michigan Board of Land Surveyors or by a Decree of a Court of Law; established, re-established, monumented, re-monumented, recovered, found as expressed below:

NOTE: Not more than 4 corners, all in the same town and range, may be recorded on this certificate.

A. Description of original monument and accessories and/or subsequent restoration:

Wood Hub Found by B. Dunning 1974

A	B	C	D	E	F	G	H	I	J	K	L	M
2	6	5	4	3	2	1						
3												
4	7	8	9	10	11	12						
5												
6	18	17	16	15	14	13						
7												
8	19	20	21	22	23	24						
9												
10	30	29	28	27	26	25						
11												
12	31	32	33	34	35	36						
13												

SURVEY &
REMONUMENTATION

1993

COMMISSION

B. Description of corner evidence found and/or method applied in restoring or reestablishing corner:

Wood Hub Found by O. Boss Sept. 1973 Reg. No. 13574
Found 1/2" Rebar by Witnesses
Found 4" x 36" Concrete Monument 1.83 South


C. Description of monument for corner and accessories established to perpetuate locating the position of the corner:

Set 1 1/4" x 36" Iron Pipe with Brass Cap (Livingston Co. Monument Corner)

West 15.20' Spike N/Side 20" Oak
N50°E 23.90' Spike S/Side 28" Oak
South 12.60' Spike E/Side 16" Oak
South 1.83' Concrete Monument

Approved by Livingston Co. Monumentation Peer Group on December 8, 1993

Signed by Bryan L. Boss Land Surveyor Date December 28, 1993
Surveyor's Michigan License No. 29238

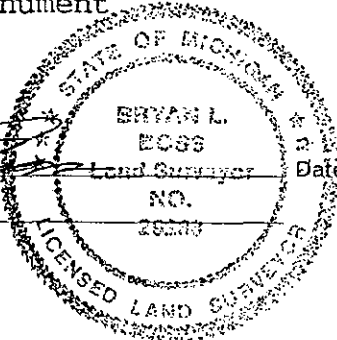

BOSS ENGINEERING
ENGINEERS & SURVEYORS

December 8, 1993

SUMMARY

I-12 West 1/4 Corner, Section 35, Genoa Township,
T2N-R5E, Livingston County, Michigan

Found 1/2" Iron 1.83 feet North and 0.30 East of monument.


L.S.C. No. 774 dated 2-15-74 shows H-12 as wood stake and I-12 as Iron found. Witnesses on certified survey show same.

Witnesses on page 7, 8 & 9 show to be contrary.

On December 6, 1993 witnesses point to iron as 1/4 corner. Page 10 and 1/4 Section calculations also bear this out.

I recommend accepting 1/2" iron over monument for the West 1/4 corner of Section 35.

File: REMON4

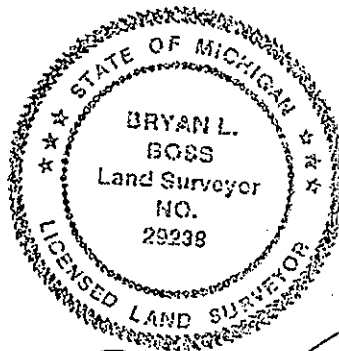

Bryan L. Boss

①