

DEC 29 11 25 AM '93

LAND CORNER RECORDATION CERTIFICATE
Filing Requirement of Act 74, Mich. P.A. 1970
NANCY HAVILAND
REGISTER OF DEEDS
LIVINGSTON COUNTY, MI.
48843

For corners in

Livingston County Located In: Corner Code ##

1. Public Land Survey	T	<u>2N</u>	R	<u>5E</u>	<u>I-13</u>
	T		R		
	T		R		
	T		R		
2. Property Controlling in Section	S		T	R	
	S		T	R	
3. Miscellaneous Property in Sec.	S		T	R	
	S		T	R	

4. Lot No. _____, Recorded Plat _____

5. Private Claims _____

L.S.C. #170m
Register of Deeds Stamp & File Number

	A	B	C	D	E	F	G	H	I	J	K	L	M
2	6		5		4		3		2		1		
3													
4	7		8		9		10		11		12		
5													
6	18		17		16		15		14		13		
7													
8	19		20		21		22		23		24		
9													
10	30		29		28		27		26		25		
11													
12	31		32		33		34		35		36		
13													

I, Bryan Boss, in a field survey on December 22, 1993, do hereby certify that under requirements of P.A. 74, Michigan P.A. of 1970, the corner points mentioned in lines 1 and 2 above were in conformance with regulations and rules therefore as required in the current manual of survey instructions of the United States Department of the Interior, Bureau of Land Management or by a decree of a Court of Law and/or that the corner points mentioned in lines 3, 4 and 5 above were in conformance with the rules of the Michigan Board of Land Surveyors or by a Decree of a Court of Law; established, re-established, monumented, re-monumented, recovered, found as expressed below:

NOTE: Not more than 4 corners, all in the same town and range, may be recorded on this certificate.

A. Description of original monument and accessories and/or subsequent restoration:

- W. Oak 11 in. Dia. S55W 29 Lks
- B. Oak 12 in. Dia. S40E 39 Lks

SURVEY &
REMONUMENTATION

1993

COMMISSION

B. Description of corner evidence found and/or method applied in restoring or reestablishing corner:

Found 1/2" Rerod in Line with Fence to South.
This Iron also Used as NW Corner, Section 2
Hamburg Township in L.S.C. 1566, L.L.S. 19834


C. Description of monument for corner and accessories established to perpetuate locating the position of the corner:

Reset with a 1 1/4" x 36" Breakaway Iron Pipe with Livingston Co. Brass Cap on Top 4 Feet ± North of Centerline Cunningham Lk. Rd.

East 10.63' 1/2" Iron Rod (Not a Sec. Cor.)
S20°W 40.46' Spike SE/Side 12" Oak
South 28.27' Spike E/Side 24" Hickory
S45°E 48.06' Spike NE/Side 12" (Dead Oak)

Approved by Livingston Co. Monumentation Peer Group on November 17, 1993

Signed by [Signature]
Surveyor's Michigan License No. 29238

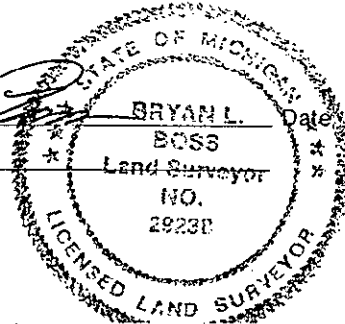

December 28, 1993

BOSS ENGINEERING

ENGINEERS & SURVEYORS


November 5, 1993

SUMMARY

I-13 Southwest corner, section 35, Genoa Township,
Livingston County, Michigan

Found $\frac{1}{2}$ " rebar in C/L Cunningham Lake Road (Gravel). Tree row and fence to North, also common Blacktop driveway to North lots 83 & 84 of "Mystic Hills No. 2". Found N.W. corner, Section 2, Hamburg Township, 10.65 West. Both corners set by Pat Benton in 1974. G.L.O Notes call for N.W. corner of Section 2 Hamburg to be 10.56 (16 Links) East of S.W. corner, Section 35. Darrell Hughes states point is both N.W. corner 2 & S.W. corner, Section 35 in L.S.C. #1566. In 1976 Donald Ross Shows S.W. corner Section 35 to be 10.56 West of N.W. Corner section 2 Hamburg. Patrick Benton survey 1977 shows he set S.W. corner Section 35. In 1979 CHMP calls S.W. corner 35 to be 10.67 West of N.E. corner Section 3. In 1993 Boss survey found $\frac{1}{2}$ " iron rod 10.63 (not a section corner).

Back to Hughes L.S.C. 1566 Paragraph "C". N.W. corner Section 2 Hamburg Township 090 degree FD $\frac{1}{2}$ " iron rod 10.63 (not a section corner).

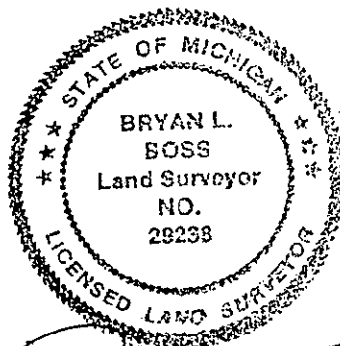

A handwritten signature in black ink, appearing to read "Bryan L. Boss", written over the bottom portion of the professional seal.