

NANCY HAVILAND  
REGISTER OF DEEDS  
LIVINGSTON COUNTY, MI.  
48843

LAND CORNER RECORDATION CERTIFICATE  
Filing Requirement of Act 74, Mich. P.A. 1970

For Corners in GENOA TWP.

LIVINGSTON  
(COUNTY)

Located In

Corner Code #

1. Public Land Survey

T2N R5E

J-3

T\_\_ R\_\_

\_\_\_\_\_

T\_\_ R\_\_

\_\_\_\_\_

T\_\_ R\_\_

\_\_\_\_\_

2. Property Controlling  
in Section

S\_\_ T\_\_ R\_\_

\_\_\_\_\_

S\_\_ T\_\_ R\_\_

\_\_\_\_\_

3. Miscellaneous  
Property in Sec.

S\_\_ T\_\_ R\_\_

\_\_\_\_\_

S\_\_ T\_\_ R\_\_

\_\_\_\_\_

4. Lot No. \_\_\_\_\_, Recorded Plat \_\_\_\_\_

5. Private Claims \_\_\_\_\_

L.S.C.#603m

REGISTER OF DEEDS STAMP & FILE NUMBER

	A	B	C	D	E	F	G	H	I	J	K	L	M
2	6	5	4	3	2	1							
3													
4	7	8	9	10	11	12							
5													
6	18	17	16	15	14	13							
7													
8	19	20	21	22	23	24							
9													
10	30	29	28	27	26	25							
11													
12	31	32	33	34	35	36							
13													

I, BRYAN L. BOSS in a field survey on OCTOBER 29, 1996, do hereby certify that under requirements of P.A. 74, Michigan P.A. of 1970, the corner points mentioned in lines 1 and 2 above were in conformance with regulations and rules therefore as required in the current manual of survey instructions of the United States Department of the Interior, bureau of Land Management or by a decree of a Court of Law and/or that the corner points mentioned in lines 3, 4 and 5 above were in conformance with the rules of the Michigan Board of Land Surveyors or by a Decree of a Court of Law, established, re-established, monumented, re-monumented, recovered, found as expressed below:

NOTE: Not more than 4 corners, all in the same town and range, may be recorded on this certificate.

A. Description of original monument and accessories and/or subsequent restoration:

ORIGINAL CORNER SET IN 1823 BY SYLVESTER SIBLEY

TAMARACK 10" S 69 1/2° W 14

TAMARACK 9" N 74° E 30

B. Description of corner evidence found and/or applied in restoring or reestablishing corner:


FOUND IRON SET ON 6-15-95 (IN SWAMP) BY BOSS ENGINEERING.

A DOUBLE DISTANCE OF 1336.69 FEET FROM THE EAST WAS HELD AND NOT THE SPLIT DISTANCE OF 2669.03 FROM THE SOUTHEAST CORNER OF SECTION 2 TO THE SOUTHWEST CORNER OF SAID SECTION.

C. Description of monument for corner and accessories established to perpetuate location the position of the corner:

SET 1 1/4 X 36" IRON PIPE WITH A BRASS CAP STAMPED "LIVINGSTON COUNTY MONUMENT CORNER".

S 80° E NAIL & TAG NORTH SIDE 12" STUMP 13.30'  
S 40° W NAIL & TAG WEST SIDE 7" MAPLE 28.90'  
N 80° W NAIL & TAG NORTH SIDE 18" MAPLE 16.80'  
N 50° W NAIL & TAG SOUTH SIDE 14" MAPLE 18.00'

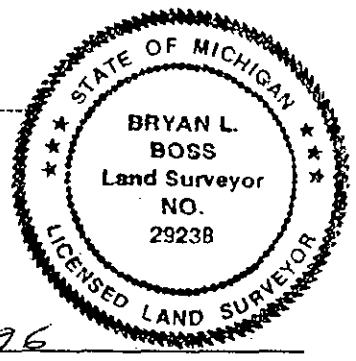

Signed by Bryan L. Boss  
Surveyor's Michigan License No. 29238

Date 11-12-1996

FORM APPROVED BY MICHIGAN STATE BOARD OF LAND SURVEYORS, JAN. 28, 1971  
REVISED MAY 14, 1975  
REVISED JAN., 1983

P.A. 345 1980, APPROVED BY LIVINGSTON COUNTY  
PEER GROUP ON 9-11-96 CO. REP JED

## SUMMARY


### J-3

North 1/4 Corner, Section 11, T2N-R5E, Genoa Township, Livingston County, Michigan.

Found Boss Iron in East and West fence. No occupation North and South.

This iron was set on June 15, 1996 in swamp. (See page 15 of this dossier). All of the witnesses were found and they checked. Note that double distance of 1336.69 feet from the East was held and not the split distance of 2669.03 feet from the Southwest corner of Section 2 and Southeast corner of said Section. (See page 11 of this dossier). This corner is open for G.P.S.

We recommend acceptance of Iron set by Boss Engineering per calculation sheet found on page 11.

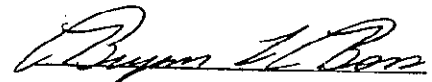

Bryan L. Boss No. 29238

