

OCT 26 1995

COMMISSION

LAND CORNER RECORDATION CERTIFICATE
Filing Requirement of Act 74, Mich. P.A. 1970

OCT 4 3 28 PM '95
HANGY HAVILANT
REGISTER OF DEEDS
LIVINGSTON COUNTY, MI
48843

FILED

For corners in

Livingston (County)	Located In:	Corner Code ##
1. Public Land Survey	T <u>2N</u> R <u>5E</u>	<u>J-5</u>
	T _____ R _____	_____
	T _____ R _____	_____
	T _____ R _____	_____
2. Property Controlling in Section	S _____ T _____ R _____	_____
	S _____ T _____ R _____	_____
3. Miscellaneous Property in Sec.	S _____ T _____ R _____	_____
	S _____ T _____ R _____	_____

L.S.C. #460m

Register of Deeds Stamp & File Number

4. Lot No. _____, Recorded Plat _____
5. Private Claims _____

	A	B	C	D	E	F	G	H	I	J	K	L	M
2	6	5	4	3	2	1							
3													
4	7	8	9	10	11	12							
5													
6	18	17	16	15	14	13							
7													
8	19	20	21	22	23	24							
9													
10	30	29	28	27	26	25							
11													
12	31	32	33	34	35	36							
13													

I, Bryan Ross, in a field survey on 8-10, 19 95,
do hereby certify that under requirements of P.A. 74, Michigan P.A. of 1970, the corner points mentioned
in lines 1 and 2 above were in conformance with regulations and rules therefore as required in the
current manual of survey instructions of the United States Department of the Interior, Bureau of Land
Management or by a decree of a Court of Law and/or that the corner points mentioned in lines 3, 4 and 5
above were in conformance with the rules of the Michigan Board of Land Surveyors or by a Decree of a
Court of Law; established, re-established, monumented, re-monumented, recovered, found as
expressed below:

NOTE: Not more than 4 corners, all in the same town and range, may be recorded
on this certificate.

Description of original monument and accessories and/or subsequent restoration:

- Black Oak 12" N 38 1/2 W 10 links
- Black Oak 14" S 60 W 12 Links
- Hickory 15" N 82 3/4 E 40


Description of corner evidence found and/or method applied in restoring or reestablishing corner:

3/4" iron pipe found in damaged fence N & S
1/2 foot below surface. No occupation East and
West.

South 156.80' 4" steel fence post
East 46.65' nail South side 14" Maple
S 30° W 142.35' nail West side telephone pole

Description of monument for corner and accessories established to perpetuate locating the position of the corner:

Set brass cap in 36" pip 2" below grade
44.19' North nail & tag East side 12" Oak
2.63' East nail & tag South side power pole
25.14 S 80° E nail & tag South side 14" Oak
11.10' S 35° E nail & tag Southwest side 8"
multiple apple

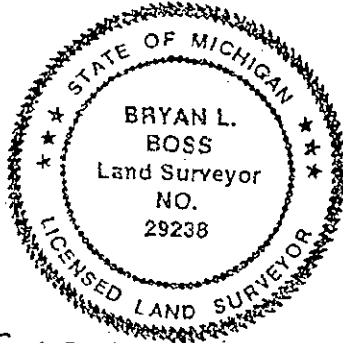

signed by Bryan L. Boss Date Sept. 28, 1995
Surveyor's Michigan License No. 29238

SUMMARY

J-5

North 1/4 Corner, Section 14, T2N-R5E, Genoa Township, Livingston County, Michigan.

Found 3/4" iron pipe in North and South fence row. No occupation East and West. Questionable corner for G.P.S. due to heavy brush in the area.


Measured to witnesses found. Found 2 of 3 Boss Engineering witnesses (pages 11-12-13-14-15-19-22-23-25-27-29) and they measured 0.15 long and 0.20 long. Found same witnesses on Donald Ross survey (page 17 this dossier). Patrick Benton witnesses (page 21) are in error.

The only comparison in distance found was Easterly to the Northeast corner of said Section 14, a difference of 0.21 feet (see pages 20 and 23 this dossier)

Conclusion:

We find the 3/4" pipe found on 12-30-94 is the same 1" pipe found on April 5, 1972 (see pages 11 and 30). On January 30, 1973 Donald Ross found same 1" pipe bent (see page 17 this dossier). Therefore, we recommend resetting bent 1" pipe 0.20 feet South to its original position.

GENJ-5S

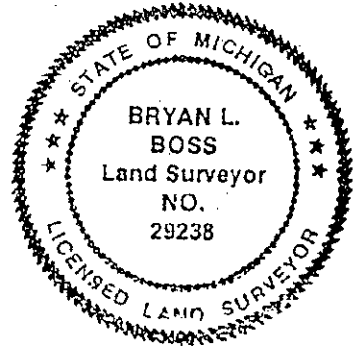

Bryan L. Boss