

OCT 26 1995

COMMISSION

LAND CORNER RECORDATION CERTIFICATE  
Filing Requirement of Act 74, Mich. P.A. 1970

For corners in

<u>Livingston</u> (County)	Located In:	Corner Code <u>J-9</u>
1. Public Land Survey	T <u>2N</u> R <u>5E</u>	<u>J-9</u>
	T _____ R _____	_____
	T _____ R _____	_____
	T _____ R _____	_____
2. Property Controlling in Section	S _____ T _____ R _____	_____
	S _____ T _____ R _____	_____
3. Miscellaneous Property in Sec.	S _____ T _____ R _____	_____
	S _____ T _____ R _____	_____

NANCY HAYLANI  
REGISTER OF DEEDS  
LIVINGSTON COUNTY, MI  
48843

OCT 14 3 20 PM '95

FILED

L.S.C. #462m

Register of Deeds Stamp & File Number

- 4. Lot No. \_\_\_\_\_, Recorded Plat \_\_\_\_\_
- 5. Private Claims \_\_\_\_\_

A	B	C	D	E	F	G	H	I	J	K	L	M
2	6	5	4	3	2							
3												
4	7	8	9	10	11	12						
5												
6	10	17	16	15	14	13						
7												
8	19	20	21	22	23	24						
9												
10	30	29	28	27	26	25						
11												
12	31	32	33	34	35	36						
13												

I, Bryan Boss, in a field survey on 8-24, 19 95, do hereby certify that under requirements of P.A. 74, Michigan P.A. of 1970, the corner points mentioned in lines 1 and 2 above were in conformance with regulations and rules therefore as required in the current manual of survey instructions of the United States Department of the Interior, Bureau of Land Management or by a decree of a Court of Law and/or that the corner points mentioned in lines 3, 4 and 5 above were in conformance with the rules of the Michigan Board of Land Surveyors or by a Decree of a Court of Law; established, re-established, monumented, re-monumented, recovered, found as expressed below:

NOTE: Not more than 4 corners, all in the same town and range, may be recorded on this certificate.

A. Description of original monument and accessories and/or subsequent restoration:


White Oak 7" North 28 links  
Black Oak 6" S 78 W 34 links

B. Description of corner evidence found and/or method applied in restoring or reestablishing corner:

1/2" iron found in monument box in centerline  
Challis Road. Subdivision monument found  
50.00 feet North. Rebar in concrete found 33.00  
feet South.  
S 58° E 34.46' spike E/S 20" Maple  
S 23° W 27.34' spike E/S 48" Oak  
S 60° W 36.00' spike W/S 30" Oak  
North 28.35' spike W/S 50" Oak

C. Description of monument for corner and accessories established to perpetuate locating the position of the corner:

Set brass cap on 1/2" iron in monument box  
28.26' North nail & tag West side 50" Oak  
60.28' S 45° E nail & tag West side power pole  
26.71' S 45° W nail & tag North side 50" Oak  
82.62' S 80° W nail & tag North side 6" Oak

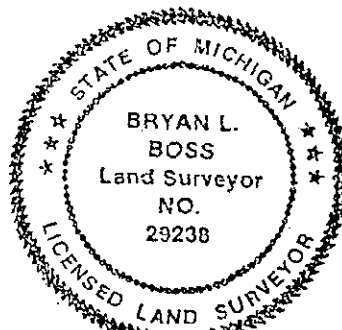

Signed by Bryan L. Boss Date Sept 28, 1995

Surveyor's Michigan License No. 29238

SUMMARY

J-9

North  $\frac{1}{4}$  Corner, Section 26, T2N-R5E, Genoa Township, Livingston County, Michigan.

Found  $\frac{1}{2}$ " iron rod in monument box in centerline of Challis Road. Fence occupation line to the South and Mountain View Subdivision to the North. Overhanging branches will make this Corner difficult to G.P.S..


Distance measured from the North  $\frac{1}{4}$  Corner of Section 26 to the Northwest Corner of said section were consistent by 3 surveyors. Distance to the Northeast Corner of Section 26 varied from 2655.81 to 2656.13 by again 3 surveyors. The distance South to the center of section was also measured by 2 surveyors with minor differences.

Found yellow painted rerod in concrete 33.00 feet South of  $\frac{1}{2}$ " rod in monument box. Calculated distance North to monument at right of way in "Mountain View Sub." due to 50 inch Oak tree being on line. The distance recorded 50.00' and calculated 50.14 feet. Monument box with  $\frac{1}{2}$ " iron rod on line North & South. All other witnesses were inconclusive.

Conclusion:

We recommend acceptance of iron and monument box as found.

GENJ-9S

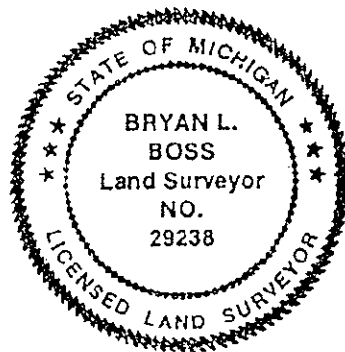

*Bryan L. Boss*