

SURVEY & REMONUMENTATION

FILED

APR 28 1995

Nov 16 2 06 PM '94

COMMISSION

LAND CORNER RECORDATION CERTIFICATE

HANCY HAVILAND
REGISTER OF DEEDS
LIVINGSTON COUNTY, MI
48843

For corners in
Livingston
(County)

Filing Requirement of Act 74, Mich. P.A. 1970

Located In: Corner Code #

- | | | |
|---------------------------------------|-------------------------|------------|
| 1. Public Land Survey | T <u>2N</u> R <u>5E</u> | <u>K-5</u> |
| | T _____ R _____ | _____ |
| | T _____ R _____ | _____ |
| | T _____ R _____ | _____ |
| 2. Property Controlling in Section | S _____ T _____ R _____ | _____ |
| | S _____ T _____ R _____ | _____ |
| 3. Miscellaneous Property in Sec. | S _____ T _____ R _____ | _____ |
| | S _____ T _____ R _____ | _____ |
| 4. Lot No. _____, Recorded Plat _____ | | |
| 5. Private Claims _____ | | |

L.S.C. #357m

Register of Deeds Stamp & File Number

A	B	C	D	E	F	G	H	I	J	K	L	M
2	6	5	4	3	2	1						
3												
4	7	8	9	10	11	12						
5												
6	16	17	16	15	14	13						
7												
8	19	20	21	22	23	24						
9												
10	30	29	28	27	26	25						
11												
12	31	32	33	34	35	36						
13												

I, Bryan Boss, in a field survey on 10-27, 19 94, do hereby certify that under requirements of P.A. 74, Michigan P.A. of 1970, the corner points mentioned in lines 1 and 2 above were in conformance with regulations and rules therefore as required in the current manual of survey instructions of the United States Department of the Interior, Bureau of Land Management or by a decree of a Court of Law and/or that the corner points mentioned in lines 3, 4 and 5 above were in conformance with the rules of the Michigan Board of Land Surveyors or by a Decree of a Court of Law; established, re-established, monumented, re-monumented, recovered, found as expressed below:

NOTE: Not more than 4 corners, all in the same town and range, may be recorded on this certificate.

A. Description of original monument and accessories and/or subsequent restoration:

White Oak 10" N 33 1/2 W 10 Links
White Oak 8" N 81 E 51 Links

Additional data on back.


B. Description of corner evidence found and/or method applied in restoring or reestablishing corner:

Found concrete monument at corner post. Occupation North, South & East.

C. Description of monument for corner and accessories established to perpetuate locating the position of the corner:

Set brass cap marked Livingston County Monument Corner on existing concrete monument.

South 12.53' N&T W/S 16" Apple
East 13.06' N&T N/S 12" Cherry
N20°E 8.88' N&T E/S 10" Pine
N60°W 33.23' N&T NE/S 6" Oak

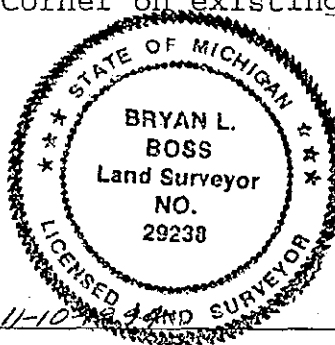

Signed by Bryan L. Boss
Surveyor's Michigan License No. 29238

Date 11-10-94

BOSS ENGINEERING ENGINEERS & SURVEYORS

SUMMARY K-5

NORTHWEST 1/4 CORNER, SECTION 13, T2N-R5E, GENOA TOWNSHIP, LIVINGSTON COUNTY, MICHIGAN.


Found concrete monument 0.50 feet above ground at corner post. Occupied fences North, South and East. Measured to witnesses found. Found 1 of 3 Boss Engineering witnesses pages 13, 14, 15, 20, 21, 23, 26, 27 and they checked. Found 1 of 3 Munzel witnesses and it checked. Found 4 of 4 Boss Engineering witnesses, pages 31, 33 and 35, they checked.

Distance from the Northwest corner of Section 13 to the West 1/8 line of Section 13 measured 1.20 difference by 4 surveyors. Distance from the Northwest corner of Section 13 to the East 1/8 line of Section 14 measured 1336.00 feet Boss Engineering and Charles Garlock. Distance from the Northwest corner of Section 13 to the West 1/4 corner of Section 12 measured 0.74 difference on 4 surveys by Boss Engineering.

Conclusion:

1936 survey by Grant Dunning, page 10, measured Easterly and Boss Engineering survey page 34, measured Easterly 8-30-93 are within 0.44 feet. Surveys by others show difference is tolerable. Distances in other directions are consistent to each other. We recommend accepting the concrete monument, as found, to be the Northwest corner of Section 13.

file: GenoaK5

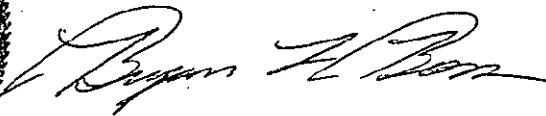

Boss Engineering Company • 3121 East Grand River • Howell, Michigan 48843
Phone (517) 546-4836 • Brighton (810) 229-4773 • Fax (517) 548-1670