

**SURVEY &  
REMONUMENTATION**

**FILED**

APR 28 1995

Nov 16 2 06 PM '94

**COMMISSION**

**LAND CORNER RECORDATION CERTIFICATE  
Filing Requirement of Act 74, Mich. P.A. 1970**

NANCY HAVILAND  
REGISTER OF DEEDS  
LIVINGSTON COUNTY, MI  
48843

For corners in  
Livingston

(County)


Located In:

Corner Code =#

1. Public Land Survey	T	<u>2N</u>	R	<u>5E</u>	<u>K-7</u>
	T		R		
	T		R		
	T		R		
2. Property Controlling In Section	S		T	R	
	S		T	R	
3. Miscellaneous Property in Sec.	S		T	R	
	S		T	R	

L.S.C. #359m  
Register of Deeds Stamp & File Number

4. Lot No. \_\_\_\_\_, Recorded Plat \_\_\_\_\_  
5. Private Claims \_\_\_\_\_

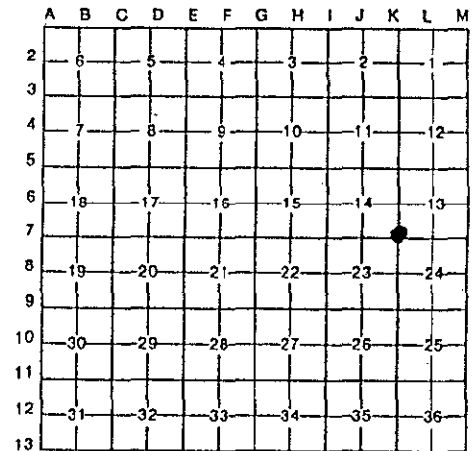

I, Bryan BOSS, in a field survey on 10-27, 1994, do hereby certify that under requirements of P.A. 74, Michigan P.A. of 1970, the corner points mentioned in lines 1 and 2 above were in conformance with regulations and rules therefore as required in the current manual of survey instructions of the United States Department of the Interior, Bureau of Land Management or by a decree of a Court of Law and/or that the corner points mentioned in lines 3, 4 and 5 above were in conformance with the rules of the Michigan Board of Land Surveyors or by a Decree of a Court of Law; established, re-established, monumented, re-monumented, recovered, found as expressed below:

NOTE: Not more than 4 corners, all in the same town and range, may be recorded on this certificate.

A. Description of original monument and accessories and/or subsequent restoration:

- White Oak 10" S 3 E 43 Links
- White Oak 8" N 7 W 45 Links
- Yellow Oak 13" N 21 3/4 E 91
- Iron Pin & Brick

Additional data on back.


B. Description of corner evidence found and/or method applied in restoring or reestablishing corner:

Found 1/2" inch iron pipe over 1/2" x 18" inch square bar with red brick 5 feet ± South of Centerline of Herbst Road and 6 feet ± East of Centerline of Hubert Road.

C. Description of monument for corner and accessories established to perpetuate locating the position of the corner:

Set 1 1/4" x 30" iron pipe raised with 1 1/4" x 6" pipe with brass cap marked Livingston County Monument Corner.

- S40°W 47.14' N&T E/S Fencepost
- N40°E 54.72' N&T W/S 14" Hickory
- N45°W 147.70' N&T SW/S 24" Pine
- S80°E 191.31' N&T N/S 6" Oak

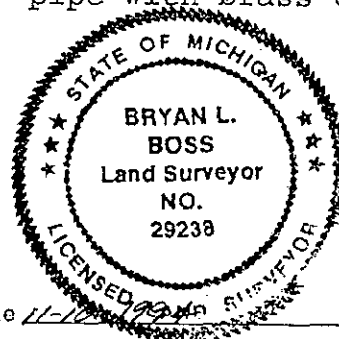

Signed by Bryan L. Boss

Date 11-10-1994

Surveyor's Michigan License No. 29238

FORM APPROVED BY MICHIGAN STATE BOARD OF LAND SURVEYORS, JAN. 28, 1971  
REVISED MAY 14, 1975  
REVISED JAN., 1983

P.A. 345 1990, APPROVED BY LIVINGSTON COUNTY  
PEER GROUP CH 31 Aug 94 CO. REP [Signature]

7-27-94

SUMMARY

K-7 SOUTHWEST CORNER SECTION 13, T2N-R5E, GENOA TOWNSHIP, LIVINGSTON COUNTY, MICHIGAN.

This Section was Surveyed May 4th 1823 by S. Sibley. Parsonage Lot Surveyed and Described in 1880 by M.W. Bullock. Also Witnessed and Described Corner by same Surveyor April 7th 1880.

Found 1/2" inch Iron Pipe 5' feet ± South of the Centerline of Herbst Road and 6' feet ± East of the Centerline of Hubert Road. 0.30 deep (Recommended Corner). Found 1" inch Pipe at Intersection of the Centerlines of Herbst Road (27' feet Gravel) and Hubert Road (24' feet Gravel).

Measured to Witnesses found. Found 2 of 3 Boss Witnesses and they checked, pages 13, 18, 20, 28. Page 24 indicates 1" inch bar found 10.50 North. Dated 7-6-92.

Raymond J. Kostecke R.L.S. #12584 Witnesses in 1979 and 1981. Pages 14 and 15 checked N.E. Quadrant Twin Hickory.

Charles E. Garlock Witnesses Pages 16, 21. Checked with 1/2" inch Pipe.

Distance from E 1/4 Corner Section 23 to N.E. Corner (K-7) is 2622.46' feet Kostecke Survey, page 15 this Dossier; 2622.63' feet M.D.O.T. Survey, page 29 this Dossier; 2622.34' feet Garlock Survey, Page 26 this Dossier.

Recorded Witnesses #109 Page 30 this Dossier which is Dated 1986 C.E.G. were found and checked.

Hubert Road (24' feet Gravel) runs North and is closed Southerly due construction of I-96.

Herbst road (27' feet Gravel) runs East and West.

Intersection clear for G.P.S..

Conclusion: 1/2" inch Iron Pipe (not 1" inch bar at Centerline-Centerline) is the correct S.W. Corner of Section 13, Genoa Township. Further investigation and evidence will be initiated to verify the placement of the 1" bar at Centerline-Centerline.

file:summary

