

SURVEY & REMONUMENTATION

APR 28 1995

COMMISSION

LAND CORNER RECORDATION CERTIFICATE
Filing Requirement of Act 74, Mich. P.A. 1970

Nov 16 2 06 PM '94

HANCOCK HAVILAND
REGISTER OF DEEDS
LIVINGSTON COUNTY, MI
48843

For corners in
Livingston
(County)

Located In: Corner Code #

- | | | |
|---------------------------------------|-------------------------|------------|
| 1. Public Land Survey | T <u>2N</u> R <u>5E</u> | <u>L-7</u> |
| | T _____ R _____ | _____ |
| | T _____ R _____ | _____ |
| | T _____ R _____ | _____ |
| 2. Property Controlling in Section | S _____ T _____ R _____ | _____ |
| | S _____ T _____ R _____ | _____ |
| 3. Miscellaneous Property in Sec. | S _____ T _____ R _____ | _____ |
| | S _____ T _____ R _____ | _____ |
| 4. Lot No. _____, Recorded Plat _____ | | |
| 5. Private Claims _____ | | |

L.S.C. #364m
Register of Deeds Stamp & File Number

I, Bryan BOSS, in a field survey on 10-27, 19 94, do hereby certify that under requirements of P.A. 74, Michigan P.A. of 1970, the corner points mentioned in lines 1 and 2 above were in conformance with regulations and rules therefore as required in the current manual of survey instructions of the United States Department of the Interior, Bureau of Land Management or by a decree of a Court of Law and/or that the corner points mentioned in lines 3, 4 and 5 above were in conformance with the rules of the Michigan Board of Land Surveyors or by a Decree of a Court of Law; established, re-established, monumented, re-monumented, recovered, found as expressed below:

NOTE: Not more than 4 corners, all in the same town and range, may be recorded on this certificate.

	A	B	C	D	E	F	G	H	I	J	K	L	M
2	6	5	4	3	2	1							
3													
4	7	8	9	10	11	12							
5													
6	18	17	16	15	14	13							
7													
8	19	20	21	22	23	24							
9													
10	30	29	28	27	26	25							
11													
12	31	32	33	34	35	36							
13													

A. Description of original monument and accessories and/or subsequent restoration:

- | | | | |
|-----------|------|---------|----------------|
| White Oak | 24" | N10E | 1.21 |
| Black Oak | 7" | N88½W | 61 |
| Black Oak | 8" | N6¼E | 93 |
| White Oak | 18" | S75W | 49.2 |
| White Oak | E'ly | 10°±28' | Stake & Stones |

Additional data on back.

B. Description of corner evidence found and/or method applied in restoring or reestablishing corner:

Found 1/3" iron rod at bend of Herbst Road Southeasterly and 20 feet North of Centerline Road. Distance checked Westerly within 1.65 feet of 1880 survey. Witnesses found checked 1/4" iron. Location fits occupation South & West.


C. Description of monument for corner and accessories established to perpetuate locating the position of the corner:

Set 1¼" x 36" iron pipe with brass cap marked Livingston County Monument Corner.

- N10°W 9.18' N&T W/S 10"Oak
- S70°W 92.81' N&T N/S 36"Oak
- South 51.56' N&T E/S 16"Oak
- S80°E 98.45' N&T S/S 26"Oak

Signed by [Signature]
Surveyor's Michigan License No. 29238

Date 11-10-1994

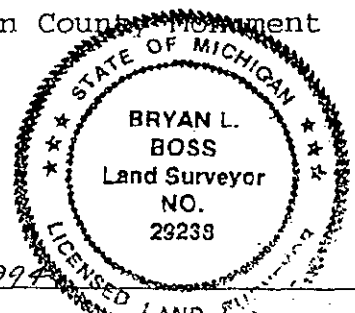

FORM APPROVED BY MICHIGAN STATE BOARD OF LAND SURVEYORS, JAN. 28, 1971
REVISED MAY 14, 1975
REVISED JAN., 1983

P.A. 346 1980, APPROVED BY LIVINGSTON COUNTY
PEER GROUP ON 5 Oct 94 CO. 29238

BOSS ENGINEERING **ENGINEERS & SURVEYORS**

SUMMARY L-7


SOUTH 1/4 CORNER, SECTION 13, T2N-R5E, GENOA TOWNSHIP, LIVINGSTON COUNTY, MICHIGAN.

Found 1/4" Iron Rod buried 0.60 feet at bend of Herbst Road Southeasterly and 20 feet North of Centerline Road. Tree row South and centerline of Herbst Road Westerly extended measured to witnesses found. Found 3 of 3 Boss Engineering witnesses pages 15 and 24 and found 4 of 4 Boss Engineering witnesses, pages 19, 20 and 31, and they checked. Found 0 of 4 of John Albright witnesses, pages 16, and 17. Found 1 of 3 Raymond Kostecke witnesses, pages 21 and 23, and it was 0.78 short. Found 3 of 3 BCA Engineering witnesses, page 22, and they checked. Distance from the South 1/4 corner of Section 13 to the Southwest corner of said Section is 2693.46 feet Miles Bullock Survey, pages 9 and 10, this Dossier; 2691.77 feet Boss Engineering surveys, pages 18, 29 and 30, this Dossier; 2691.86 feet Charles Garlock survey, page 25, this Dossier. Distance from the South 1/4 corner of Section 13 to the Southeast corner of said section is 2678 feet and 2608 feet Grant Dunning surveys, pages 11 and 12, this Dossier; 2672.14 feet Boss Engineering surveys, pages 15 and 32, this Dossier; 2672.25 feet BCA Engineering survey, page 22, this Dossier; 2678.03 feet Charles Garlock survey, page 25, this Dossier. There are no distance comparisons North or South heavily wooded area will not be conducive for G.P.S.

Conclusion:

All surveys (except Boss Engineering Act 74, page 20) call for 1/4" Iron Found. Witnesses found checked iron. Distance Westerly checked within 1.65 feet of 1880 Bullock survey. Location also fits occupation South and West. We recommend accepting 1/4" Iron as found to be the South 1/4 corner of Section 13.

file: Genoa17

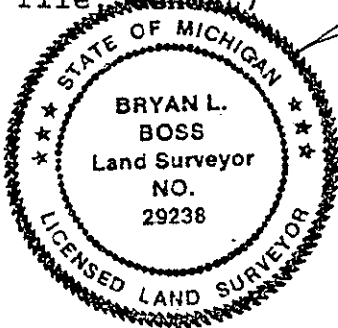

Bryan L. Boss

Boss Engineering Company • 3121 East Grand River • Howell, Michigan 48843
Phone (517) 546-4836 • Brighton (810) 229-4773 • Fax (517) 548-1670