

FILED

DEC 29 11 06 AM '93

LAND CORNER RECORDATION CERTIFICATE  
Filing Requirement of Act 74, Mich. P.A. 1970

NANCY HAVILAND  
REGISTER OF DEEDS  
LIVINGSTON COUNTY, MI  
48843

For corners in

Livingston Located In: Corner Code #  
(County)

1. Public Land Survey	T <u>2N</u> R <u>5E</u>	<u>L-13</u>
	T _____ R _____	_____
	T _____ R _____	_____
	T _____ R _____	_____
2. Property Controlling in Section	S _____ T _____ R _____	_____
	S _____ T _____ R _____	_____
3. Miscellaneous Property in Sec.	S _____ T _____ R _____	_____
	S _____ T _____ R _____	_____

L.S.C. #188m  
Register of Deeds Stamp & File Number

4. Lot No. \_\_\_\_\_, Recorded Plat \_\_\_\_\_  
5. Private Claims \_\_\_\_\_

I, Bryan Boss, in a field survey on December 22, 1993, do hereby certify that under requirements of P.A. 74, Michigan P.A. of 1970, the corner points mentioned in lines 1 and 2 above were in conformance with regulations and rules therefore as required in the current manual of survey instructions of the United States Department of the Interior, Bureau of Land Management or by a decree of a Court of Law and/or that the corner points mentioned in lines 3, 4 and 5 above were in conformance with the rules of the Michigan Board of Land Surveyors or by a Decree of a Court of Law; established, re-established, monumented, re-monumented, recovered, found as expressed below:

NOTE: Not more than 4 corners, all in the same town and range, may be recorded on this certificate.

A. Description of original monument and accessories and/or subsequent restoration:

- Surveyed December 15, 1815
- B. Oak 12 in. Dia. N45E 7 Lks
- B. Oak 14 in. Dia. S23W 20 Lks

	A	B	C	D	E	F	G	H	I	J	K	L	M
2	6	5	4	3	2	1							
3													
4	7	8	9	10	11	12							
5													
6	18	17	16	15	14	13							
7													
8	19	20	21	22	23	24							
9													
10	30	29	28	27	26	25							
11													
12	31	32	33	34	35	36							
13													

SURVEY &  
REMONUMENTATION

1993

COMMISSION

B. Description of corner evidence found and/or method applied in restoring or reestablishing corner:


Found 1" Pipe 20 Feet ± East of Centerline Gravel Driver (Private)

C. Description of monument for corner and accessories established to perpetuate locating the position of the corner:

- Set 1 1/4" x 36" Iron Pipe with Brass Cap (Livingston Co. Mon. Corner)
- N60°W 48.83' Spike N/Side 14" Pine
- N60°E 19.69' Spike S/Side 40" Oak
- S60°E 41.91' Spike W/Side 32" Maple
- S45°W 60.58' Spike SE/Side 18" W. Oak
- West 19.80' 1 1/2" Pipe Centerline Gravel Dr.

Approved by Livingston Co. Monumentation Peer Group on November 23, 1993

Signed by \_\_\_\_\_  
Surveyor's Michigan License No. 29238

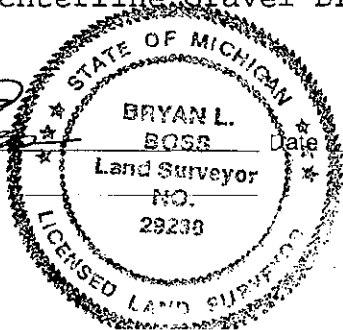

December 28, 1993