

APR 28 1995

Nov 16 2 06 PM '94

COMMISSION

LAND CORNER RECORDATION CERTIFICATE
Filing Requirement of Act 74, Mich. P.A. 1970

NANCY HAVILAND
REGISTER OF DEEDS
LIVINGSTON COUNTY, MI
48843

For corners in
Livingston
(County)

Located In: Corner Code #/

1. Public Land Survey	T	<u>2N</u>	R	<u>5E</u>	<u>M-5</u>
	T		R		
	T		R		
	T		R		
2. Property Controlling in Section	S		T	R	
	S		T	R	
3. Miscellaneous Property in Sec.	S		T	R	
	S		T	R	

L.S.C. #366m

Register of Deeds Stamp & File Number

4. Lot No. _____, Recorded Plat _____
5. Private Claims _____

	A	B	C	D	E	F	G	H	I	J	K	L	M
2	6		5		4		3		2		1		
3													
4	7		8		9		10		11		12		
5													
6	13		17		16		15		14		13		
7													
8	19		20		21		22		23		24		
9													
10	30		29		28		27		26		25		
11													
12	31		32		33		34		35		36		
13													

I, Bryan BOSS, in a field survey on 10-27, 1994, do hereby certify that under requirements of P.A. 74, Michigan P.A. of 1970, the corner points mentioned in lines 1 and 2 above were in conformance with regulations and rules therefore as required in the current manual of survey instructions of the United States Department of the Interior, Bureau of Land Management or by a decree of a Court of Law and/or that the corner points mentioned in lines 3, 4 and 5 above were in conformance with the rules of the Michigan Board of Land Surveyors or by a Decree of a Court of Law; established, re-established, monumented, re-monumented, recovered, found as expressed below:

NOTE: Not more than 4 corners, all in the same town and range, may be recorded on this certificate.

A. Description of original monument and accessories and/or subsequent restoration:

- White Oak 18" N 29 E 87 Links
- White Oak 20" S 32 W 1.46
- Black Oak 14" S 36 E 87 Links

Additional data on back.


B. Description of corner evidence found and/or method applied in restoring or reestablishing corner:

Found railroad spike at surface of Hacker Road. 1 1/2 feet East of centerline.

C. Description of monument for corner and accessories established to perpetuate locating the position of the corner:

Cored and set Monument Box. Set 1 1/4" x 30" iron pipe with brass cap marked Livingston County Monument Corner.

- N80°W 61.20' N&T N/S Power Pole
- N60°E 32.78' N&T N/S 12"Oak
- S45°E 39.94' N&T NE/S 8"Oak
- S30°W 64.52' N&T W/S 30"Maple

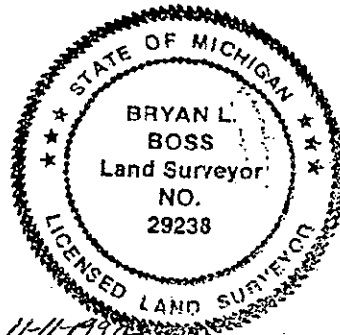

Signed by [Signature] Date 11-11-1994

Surveyor's Michigan License No. 29238

SUMMARY

M-5 NORTHEAST CORNER SECTION 13 T2N-R5E, GENOA TOWNSHIP, LIVINGSTON COUNTY, MICHIGAN.

Original Township Lines Surveyed in 1816 by Alex Holmes D.S.. Sections were then surveyed in 1823 by S. Sibley. M.W. Bullocks field notes, page 10 this Dossier, shows 1.95 chains jog at Township Corner.

Found railroad spike at surface of Hacker Road (22' feet asphalt) 1 1/2' feet East of Centerline.

Measured to Witnesses found. Found 1 of 4 Witnesses from 1935 Field Notes, page 16 this Dossier, and it checked. Found 2 of 3 Boss Engineering Witnesses, pages 21, 22, 24, 26, 28, 30, 32, 34 and they checked.

Distance from the East 1/4 Corner to the Northeast Corner of Section 13 is 2653' feet Grant Dunning Surveys, pages 13 and 14, this Dossier; 2644.73' feet page 20, 2644.93' feet, page 23 Boss Engineering Surveys; 2645.08' feet. Pat Benton Survey page 27; and 2648.25 feet on M.W. Bullocks Field Notes, page 11 of this Dossier.

Distance from the North 1/4 Corner to the Northeast Corner of Section 13 is 2695' feet Grant Dunning Surveys pages 13 and 14 this Dossier; 2696.54' feet page 23; 2697.11 feet, page 29 Boss Engineering Surveys this Dossier; 2697.04' feet Pat Benton Survey, page 27 this Dossier; and 2697.9 Russell Cole Survey page 37 this Dossier.

Over hanging trees may cause some difficulty for G.P.S..

Northwest Quadrant under development for subdivision, softball field East of Corner and no visible occupation exists Westerly.

Jog at Northwest Corner Section 18, Brighton Township, T2N-R6E is 1.95 chains (128.7' feet) G.L.O. and 112.84' feet Boss Survey, page 20 and 25 this Dossier. 112.79' feet Boss Survey, page 31 this Dossier. Made a clean sweep of immediate area and found no additional Corners or Irons.

file Summary6

