

SURVEY & REMONUMENTATION

"FILED"

APR 28 1995

DEC 12 9 52 AM '94

LAND CORNER RECORDATION CERTIFICATE
COMMISSION Filing Requirement of Act 74, Mich. P.A. 1970

NANCY HAVIL AND
 REGISTER OF DEEDS
 LIVINGSTON COUNTY, MI
 48843

For corners in

Livingston
(County)

Located In:

Corner Code M-8

- | | | |
|------------------------------------|-------------------------|------------|
| 1. Public Land Survey | T <u>2N</u> R <u>5E</u> | <u>M-8</u> |
| | T _____ R _____ | _____ |
| | T _____ R _____ | _____ |
| | T _____ R _____ | _____ |
| 2. Property Controlling in Section | S _____ T _____ R _____ | _____ |
| | S _____ T _____ R _____ | _____ |
| 3. Miscellaneous Property in Sec. | S _____ T _____ R _____ | _____ |
| | S _____ T _____ R _____ | _____ |

L.S.C.#386m

Register of Deeds Stamp & File Number

4. Lot No. _____, Recorded Plat _____
5. Private Claims _____

	A	B	C	D	E	F	G	H	I	J	K	L	M
2	6		5		4		3		2		1		
3													
4	7		8		9		10		11		12		
5													
6	18		17		16		15		14		13		
7													
8	19		20		21		22		23		24		
9													
10	30		29		28		27		26		25		
11													
12	31		32		33		34		35		36		
13													

I, Bryan Boss, in a field survey on 11-18, 19 94, do hereby certify that under requirements of P.A. 74, Michigan P.A. of 1970, the corner points mentioned in lines 1 and 2 above were in conformance with regulations and rules therefore as required in the current manual of survey instructions of the United States Department of the Interior, Bureau of Land Management or by a decree of a Court of Law and/or that the corner points mentioned in lines 3, 4 and 5 above were in conformance with the rules of the Michigan Board of Land Surveyors or by a Decree of a Court of Law; established, re-established, monumented, re-monumented, recovered, found as expressed below:

NOTE: Not more than 4 corners, all in the same town and range, may be recorded on this certificate.

A. Description of original monument and accessories and/or subsequent restoration:

- | | | | |
|-----------|-----|--------|------------|
| White Oak | 12" | S 11 E | 5.10 Links |
| Black Oak | 15" | N 17 E | 23 Links |
| Maple | 5" | S 45 E | 43½ Links |

Additional data on back.

B. Description of corner evidence found and/or method applied in restoring or reestablishing corner:


Found East 1/4 corner Section 24 set by R.L.S. #23828 on June 6, 1994. Corner was previously obliterated for construction of I-96 expressway.

Borrow pit area.

C. Description of monument for corner and accessories established to perpetuate locating the position of the corner:

Set 1 1/4" x 36" iron pipe with brass cap marked Livingston County Monument Corner per information furnished by R.L.S. #23828 Bryan Thompson.

- North 207.34' to fence post east
- N60°E 97.55' N&T W/S power pole
- West 153.37' fence corner post/North R.O.W. of I-96
- S60°E 65.56' Weldmark W/S of 36" sign post

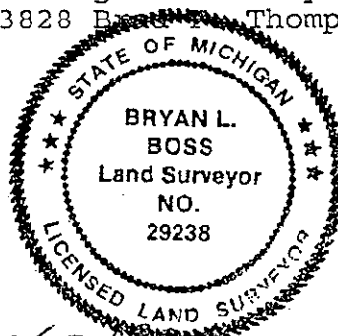

Signed by Bryan L. Boss

Date 12-6-94

Surveyor's Michigan License No. 29238

BOSS ENGINEERING ENGINEERS & SURVEYORS

SUMMARY M-8

EAST 1/4 CORNER SECTION 24, T2N-R5E GENOA TOWNSHIP LIVINGSTON COUNTY MICHIGAN.

On May 6th 1994 we found corner obliterated by excavation for borrow pit North of Right-of-Way I-96. All Witnesses destroyed. Returned one month later and found East 1/4 Corner Section 24 and W 1/4 Corner Section 19 T2N-R6E Brighton Township had been set by Brad F. Thompson (capped 1/2" Irons).

Township jog recorded and measured 90.27' feet.

Township Line originally Surveyed by Holmes in 1815. Sections, Surveyed in 1823 by S. Sibley.


Distance from the East 1/4 Corner of Section 24 to the Northeast Corner of said Section is 2655.31' feet page 16, 2655.14' feet, page 17 and 2654.94' feet page 28 Boss Engineering Surveys this Dossier and 2654.06' feet BCA Engineering page 27.

Distance to the center of Section from the East 1/4 Corner is 2677.37' feet Boss Survey page 23. Distance from the East 1/4 Corner of Section 24 to the Southwest Corner of Said Section is 2601.55' feet M.D.O.T. Right-of-Way map, page 22, 2600.14" feet Brad Thompson Survey, page 25 this Dossier; 2589.17' feet Boss Survey, page 23.

New Witnesses set by Brad Thompson, page 26, on 6-06-94.

Terrain is open and visible for G.P.S..

Conclusion: Extensive Survey North and South of Corner by Brad Thompson, which included 12 reference, should merit approval as found.

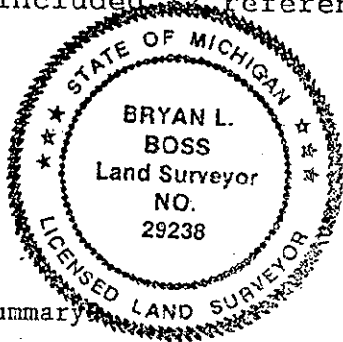

A handwritten signature in black ink, appearing to read "Bryan L. Boss".

file: summary