

**SURVEY &
REMONUMENTATION**

FILED

APR 28 1995

Nov 16 2 06 PM '94

COMMISSION

LAND CORNER RECORDATION CERTIFICATE
Filing Requirement of Act 74, Mich. P.A. 1970

NANCY HAVILAND
REGISTER OF DEEDS
LIVINGSTON COUNTY, MI
48843

For corners in
Livingston

(County)

Located In:

Corner Code #

- | | | | | | |
|---------------------------------------|---|-----------|---|-----------|-------------|
| 1. Public Land Survey | T | <u>2N</u> | R | <u>5E</u> | <u>M-10</u> |
| | T | | R | | |
| | T | | R | | |
| | T | | R | | |
| 2. Property Controlling
In Section | S | | T | R | |
| | S | | T | R | |
| 3. Miscellaneous
Property in Sec. | S | | T | R | |
| | S | | T | R | |

L.S.C. #370m
Register of Deeds Stamp & File Number

4. Lot No. _____, Recorded Plat _____
5. Private Claims _____

	A	B	C	D	E	F	G	H	I	J	K	L	M
2	6		5		4		3		2		1		
3													
4	7		8		9		10		11		12		
5													
6	18		17		16		15		14		13		
7													
8	19		20		21		22		23		24		
9													
10	30		29		28		27		26		25		
11													
12	31		32		33		34		35		36		
13													

I, Bryan Boss, in a field survey on 10-27, 19 94, do hereby certify that under requirements of P.A. 74, Michigan P.A. of 1970, the corner points mentioned in lines 1 and 2 above were in conformance with regulations and rules therefore as required in the current manual of survey instructions of the United States Department of the Interior, Bureau of Land Management or by a decree of a Court of Law and/or that the corner points mentioned in lines 3, 4 and 5 above were in conformance with the rules of the Michigan Board of Land Surveyors or by a Decree of a Court of Law; established, re-established, monumented, re-monumented, recovered, found as expressed below:

NOTE: Not more than 4 corners, all in the same town and range, may be recorded on this certificate.

A. Description of original monument and accessories and/or subsequent restoration:

White Oak 18" N 86 E 3.6 Links
Black Oak 12" N 61 W 37 Links

Additional data on back.


B. Description of corner evidence found and/or method applied in restoring or reestablishing corner:

Found 1/2" iron rod at the surface of ground in a 3-way fence corner. Also found west 1/4 corner of Section 30, Brighton Township measured 21.60 feet. G.L.O. is 32.5 Links (21.45 feet).

C. Description of monument for corner and accessories established to perpetuate locating the position of the corner:

Set 1 1/4" x 36" iron pipe with brass cap marked Livingston County Monument Corner 0.15' feet North of existing location.

West 12.21' N&T S/S 7" Elm
N20°W 22.74' N&T E/S 5" Cherry
N15°E 25.53' N&T W/S 20" Oak
S10°E 17.52' N&T W/S 12" Oak
North 21.47' 1" Pipe & Cap

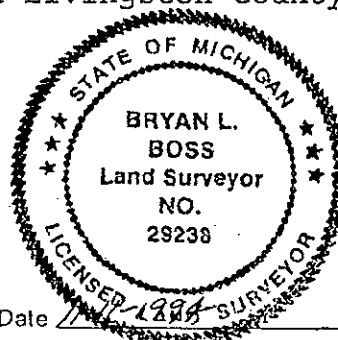

Signed by [Signature]
Surveyor's Michigan License No. 29238

Date 11/16/94

SUMMARY
M-10


EAST 1/4 CORNER, SECTION 25, T2N-R5E, GENOA TOWNSHIP, LIVINGSTON COUNTY, MICHIGAN.

Found 1/2" Iron Rod at the surface in a 3-way fence corner. Also found the West 1/4 corner of Section 30, T2N-R6E, Brighton Township. We measured 21.60 feet between corners, page 24, this Dossier. G.L.O. on Page 9 calls for 32 1/2 Links (21.45 feet); Miles Bullock, page 10, measures 21.45 feet; Munsell & Garlock, page 11, measures 21.5 feet; Patrick Benton, page 21 and Boss Engineering pages 23 and 24, measures 21.60 feet. Measured to witnesses found. Boss Engineering witnesses page 16, 18 are to West 1/4 corner of Section 30, Brighton Township (see page 23 to verify). This will also justify 21.26 feet difference in distance from East 1/4 corner of Section 25 to the Southeast corner, page 6, this Dossier. Found 3 of 4 Munsell & Garlock witnesses, page 19 and 20. Witness to West 1/4 corner Section 30 checked. Witness N15°E is 0.80 short; witness S35°E is 1.08 long.

Conclusion:

We recommend placement 0.15 feet North to re-establish original G.L.O. surveyed position.

file: Genoam10.

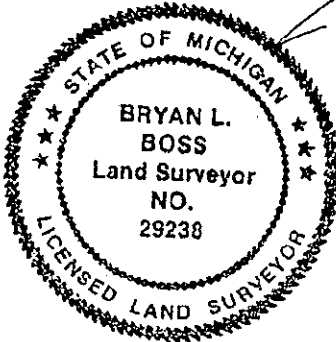

Bryan L. Boss