

1993

Dec 29 11 25 AM '93

COMMISSION

LAND CORNER RECORDATION CERTIFICATE
Filing Requirement of Act 74, Mich. P.A. 1970

NANCY HAVILAND
REGISTER OF DEEDS
LIVINGSTON COUNTY, MI
48843

For corners in

Livingston Located In: Corner Code #
(County)

1. Public Land Survey	T <u>2N</u> R <u>5E</u>	<u>M-11</u>
	T _____ R _____	_____
	T _____ R _____	_____
	T _____ R _____	_____
2. Property Controlling in Section	S _____ T _____ R _____	_____
	S _____ T _____ R _____	_____
3. Miscellaneous Property in Sec.	S _____ T _____ R _____	_____
	S _____ T _____ R _____	_____

L.S.C. #173m
Register of Deeds Stamp & File Number

- 4. Lot No. _____, Recorded Plat _____
- 5. Private Claims _____

	A	B	C	D	E	F	G	H	I	J	K	L	M
2	6		5		4		3		2		1		
3													
4	7		8		9		10		11		12		
5													
6	13		17		16		15		14		13		
7													
8	19		20		21		22		23		24		
9													
10	30		29		28		27		26		25		
11													
12	31		32		33		34		35		36		
13													

I, Bryan Boss, in a field survey on December 22, 1993, do hereby certify that under requirements of P.A. 74, Michigan P.A. of 1970, the corner points mentioned in lines 1 and 2 above were in conformance with regulations and rules therefore as required in the current manual of survey instructions of the United States Department of the Interior, Bureau of Land Management or by a decree of a Court of Law and/or that the corner points mentioned in lines 3, 4 and 5 above were in conformance with the rules of the Michigan Board of Land Surveyors or by a Decree of a Court of Law; established, re-established, monumented, re-monumented, recovered, found as expressed below:

NOTE: Not more than 4 corners, all in the same town and range, may be recorded on this certificate.

A. Description of original monument and accessories and/or subsequent restoration:

- B. Oak 12 in. Dia. S40E 12 Lks.
- B. Oak 18 in. Dia. N74W 38 Lks.

B. Description of corner evidence found and/or method applied in restoring or reestablishing corner:

Found 1/4" Square Bar 10.18 Feet South of Centerline Brighton Road


C. Description of monument for corner and accessories established to perpetuate locating the position of the corner:

Set 1/2" x 30" Iron Rod and Raised with 1 1/4" x 6" Pipe with Brass Cap Marked Livingston Co. Mon. Corner Set Mon. Box

- N49°W 42.45' Spike S/Side 18" Twin Oak
- N20°E 90.89' Spike W/Side Power Pole
- S64°E 33.49' Spike N/Side Power Pole
- S80°W 74.25' Spike N/Side Power Pole

Approved by Livingston Co. Monumentation Peer Group on October 30, 1993

Signed by Bryan L. Boss
Surveyor's Michigan License No. 29238

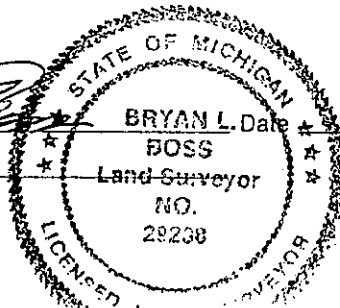

December 28, 1993

Summary

M-11 NORTHEAST CORNER, SECTION 36, T2N-R5E,
 GENOA TOWNSHIP, LIVINGSTON COUNTY, MICHIGAN

Intersection of Brighton Road and Seventh Street.


In 1982 Herbert Munzels act 74 certificate - A-11 Brighton Township 1/4" rod found 0.35 South of South edge of pavement.

In 1986 Arvin Butterfield Act 74 certificate #1354 & 1360 call for A-11 as boat spike center of pavement. 1/4" square bar NE corner Section 36, Genoa, South 10.18.

Boss 1989 shows SE corner, Section 25, Genoa, square bar and A-11 5/8" Bolt 10.12 North.

Boss 1991 shows 10.18 between corners.

Note: 10' difference on Clay Gordon 1940 Plat of Sunset Subdivision.

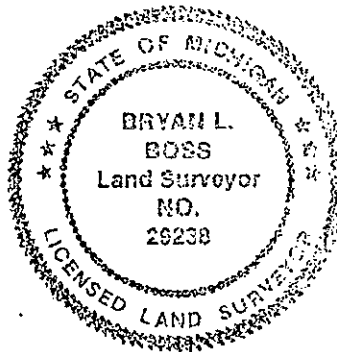

A handwritten signature in cursive script, appearing to read "Bryan L. Boss", written in dark ink below the professional seal.

file: Witness