

**SURVEY & REMONUMENTATION**

**JUN 01 1998**

**LAND CORNER RECORDATION CERTIFICATE**  
Filing Requirement of Act 74, Mich. P.A. 1970

**FILED**

**SECTION**  
For corners in

**LIVINGSTON**  
(County)

Located In:  
GENOA TWP.

Corner Code //

- |   |                                 |      |      |      |     |
|---|---------------------------------|------|------|------|-----|
| 1 | Public Land Survey              |      | I    | R    |     |
|   |                                 |      | I    | R    |     |
|   |                                 |      | I    | R    |     |
|   |                                 |      | I    | R    |     |
| 2 | Property Controlling in Section | S    | I    | R    |     |
|   |                                 | S    | T    | R    |     |
| 3 | Miscellaneous Property in Sec.  | S 33 | T 2N | R 5E | 001 |
|   |                                 | S    | T    | R    |     |
|   |                                 | S    | T    | R    |     |

9-

1998 MAY 29 P 1:44

NANCY HAVILAND  
REGISTER OF DEEDS  
LIVINGSTON COUNTY, MI.  
48843

L.S.C.#841m

See L.S.C.#830m (a)  
Register of Deeds Stamp & File Number

Recorded Plat

	A	B	C	D	E	F	G	H	I	J	K	L	M
2	6		5		4		3		2				
3													
4	7		8		9		10		11		12		
5													
6	18		17		16		15		14		13		
7													
8	19		20		21		22		23		24		
9													
10	30		29		28		27		26		25		
11													
12	31		32		33		34		35		36		
13													

I, **BRYAN L. BOSS**, in a field survey on **NOVEMBER 3, 1997**, do hereby certify that under requirements of P.A. 74, Michigan P.A. of 1970, the corner points mentioned in lines 1 and 2 above were in conformance with regulations and rules therefore as required in the current manual of survey instructions of the United States Department of the Interior, Bureau of Land Management or by a decree of a Court of Law and/or that the corner points mentioned in lines 3, 4 and 5 above were in conformance with the rules of the Michigan Board of Land Surveyors or by a Decree of a Court of Law; established, re-established, monumented, re-monumented, recovered, found as expressed below.

**NOTE:** Not more than 4 corners, all in the same town and range, may be recorded on this certificate.

A Description of original monument and accessories and/or subsequent restoration.


WHITE OAK 8" N 80 E 2.20 CHAINS.  
NO OTHER TIMBER NEAR.

B Description of corner evidence found and/or method applied in restoring or reestablishing corner.

THIS IS A LOST CORNER.  
THE EXISTING CHILSON POND NOW COVERS THIS AREA.  
RECOMMENDED SETTING REFERENCE MONUMENTS EAST AND ON  
LINE WITH SOUTHWEST CORNER, SECTION 33 AT SPLIT DISTANCE.

C Description of monument for corner and accessories established to perpetuate locating the position of the corner

-001 OF 3  
SET 1 1/2 X 36" PIPE WITH BRASS CAP STAMPED  
"LIVINGSTON COUNTY MONUMENTATION WITNESS"  
WEST SIDE CHILSON POND .17± WEST OF SHORELINE  
NORTH 20.11' N&T WEST SIDE 8" TRI-CHERRY  
EAST 6.61' N&T NORTH SIDE 12" POPLAR  
SOUTH 21.22' N&T EAST SIDE 8" CHERRY  
N 85° W 9.62' N&T NORTH SIDE 6" POPLAR  
377.49' SOUTH 1/4 CORNER (INACCESSIBLE) N 86°51'04"E

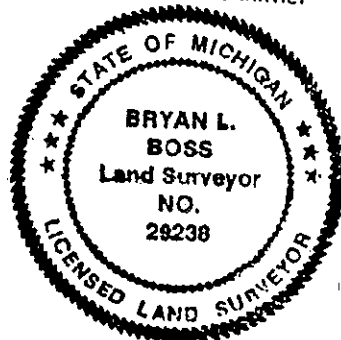

signed by *Bryan L. Boss*  
Surveyor's Michigan License No. 29238.

Date MAY 28 1998

P.A. 345 1980, APPROVED BY LIVINGSTON COUNTY  
PEER GROUP ON 9-3-97 CO. REP JED

**SUMMARY  
F-13**

South 1/4 Corner, Section 33, Genoa Township.


In December 1815, Alex Holmes set post at 40 chains and recorded one witness.

On 9-17-1948, S.V. Higgins of the Department of Natural Resources surveyed from South 1/4 Corner and set 3/4" Inch pipes in creek and in Chilson Road.

A dam has been constructed between 1950 and the present, North of F-13 approximately 1300 feet  $\pm$ . The existing Chilson pond now covers this area and upstream into Section 4, Hamburg Township, about 1/2 mile.

This is now a lost corner.

We recommend setting reference monuments East and on line with the approved Southeast Corner of Section 33 and West and on line WITH the approved Southwest Corner Section 33, at the split distance. Bearings AND distances to be recorded on Act 74 with submission of dossier.

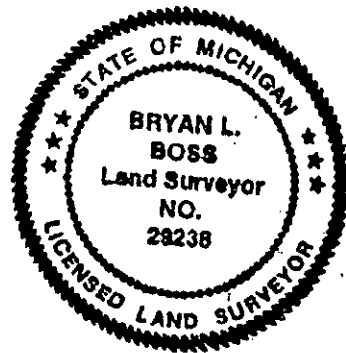

*Bryan L. Boss*