

FEB 26 2001

SECTION

LAND CORNER RECORDATION CERTIFICATE
Filing Requirement of Act 74, Mich. P.A. 1970

FILED

For corners in
LIVINGSTON
(County)

Located in: GENOA Corner Code #

2000 NOV 29 A 9:50

NANCY HAVILAND
REGISTER OF DEEDS
LIVINGSTON COUNTY, MI.
48843

- 1. Public Land Survey T 2N R 5E D-7
 T _____ R _____
 T _____ R _____
 T _____ R _____
- 2. Property Controlling S _____ T _____ R _____
 in Section S _____ T _____ R _____
- 3. Miscellaneous S _____ T _____ R _____
 Property in Sec. S _____ T _____ R _____


LSC #1386m

Register of Deeds Stamp and File Number

- 4. Lot No. _____, Recorded Plat _____
- 5. Private Claims _____

I, Bryan L. Boss, in a field survey on FEBRUARY 28, 2000, do hereby certify that under requirements of P.A. 74, Michigan P.A. of 1970, the corner points mentioned in lines 1 and 2 above were in conformance with regulations and rules therefor as required in the current manual of survey instructions of the United States Department of the Interior, Bureau of Land Management or by a decree of a Court of Law and/or that the corner points mentioned in lines 3, 4 and 5 above were in conformance with the rules of the Michigan Board of Land Surveyors or by a Decree of a Court of Law; established, re-established, monumented, re-monumented, recovered, found as expressed below.

NOTE: Not more than 4 corners, all in the same town and range, may be recorded on this certificate.

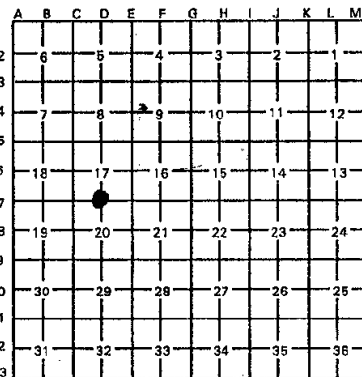

A. Description of original monument and accessories and/or subsequent restoration:

1823 BY S. SIBLEY, DEPUTY SURVEYOR
SET POST
W. OAK 11" N 73 1/2" E 1.27 CHAINS
W. OAK 8" N 16" W 1.05 CHAINS

B. Description of corner evidence found and/or method applied in restoring or reestablishing corner:

FOUND 1/2" CAPPED CORNERSTONE IRON IN CENTER LINE
CROOKED LAKE RD

C. Description of monument for corner and accessories established to perpetuate locating the position of the corner:

SET 1 1/4" X 3/8" PIPE WITH 6" BREAKAWAY PIPE
AND A BRASS CAP STAMPED "LIVINGSTON
COUNTY REMONUMENTATION CORNER".
NORTH 143.08' SET REMON NAIL/TAG E/SIDE
POWER POLE
N 40° E 82.20' SET REMON NAIL/TAG SE/SIDE
APPLE TREE
N 60° E 60.28' SET REMON NAIL/TAG S/SIDE 24"
MAPLE
S 5° E 107.78' NORTHEAST CORNER RED GARAGE

P.A. 345 1990, APPROVED BY LIVINGSTON COUNTY
PEER GROUP ON 2/2/2000 CO. REP JED



Signed by Bryan L. Boss
Surveyor's Michigan License No. 29238

Date NOV. 15, 2000