

SURVEY &
REMONUMENTATION


MISC. CORNERS -
MARK & NUMBER

BRIGHTON TWP.

JUN 01 1998

T2N , R6E

SECTION

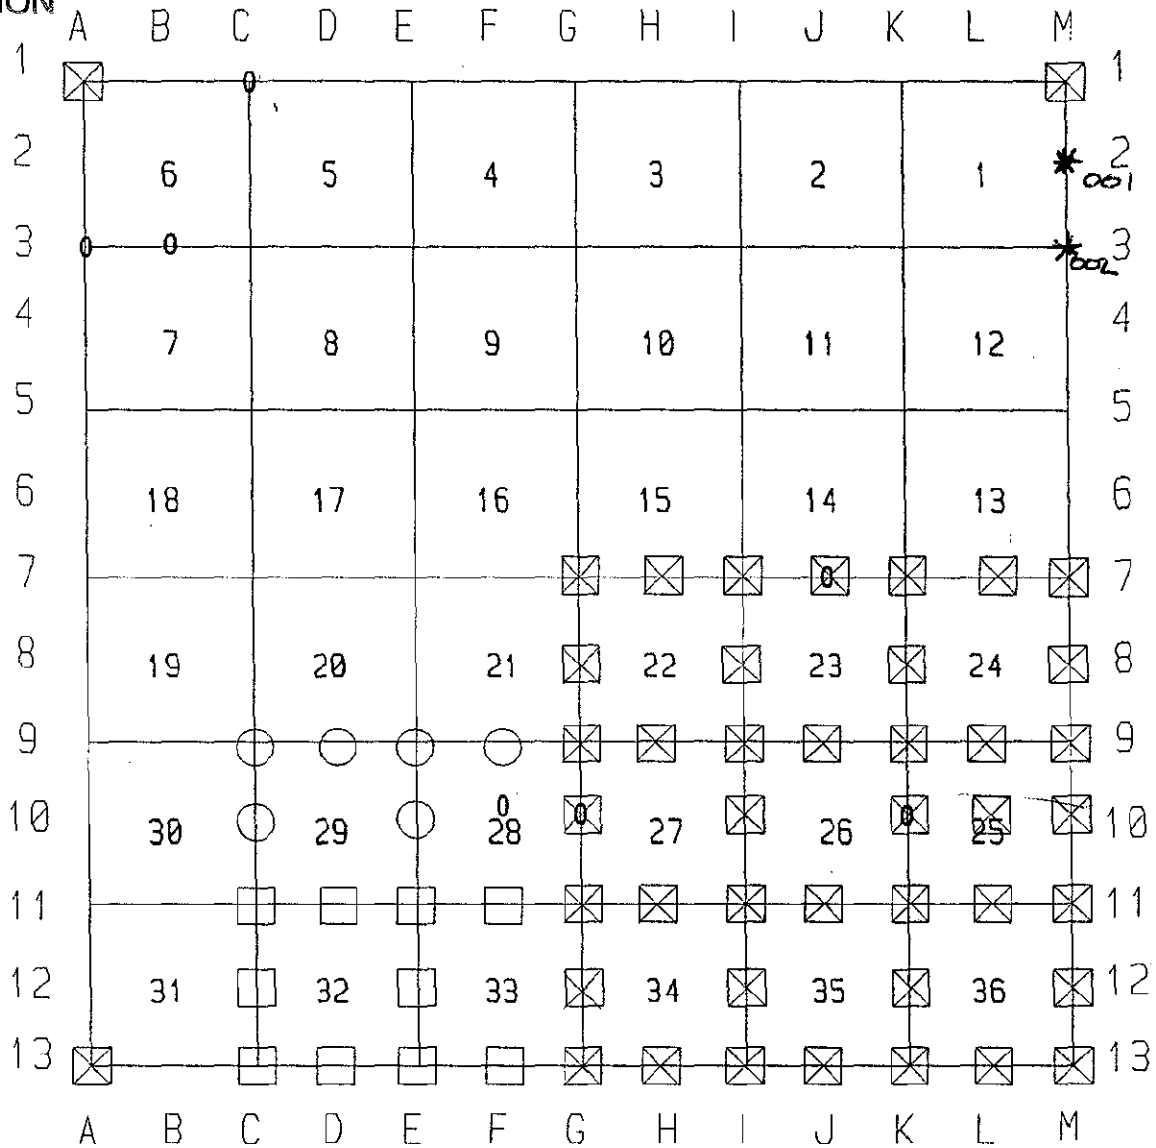

LEGEND

- ☒ CORNERS COMPLETED TO DATE
- 1996 PROPOSED CORNERS
- 1997 PROPOSED CORNERS
- 0 DOUBLE/PROBLEM CORNERS

PREPARED BY: LIVINGSTON COUNTY EQUALIZATION DEPT. 3/96