

9-

LAND CORNER RECORDATION CERTIFICATE
Filing Requirement of Act 74, Mich. P.A. 1970

FILED

For Corners in BRIGHTON TWP.

1996 DEC -3 P 3:00K
NANCY HAVILAND
REGISTER OF DEEDS
LIVINGSTON COUNTY, MI.
40043

<u>LIVINGSTON</u> (COUNTY)	Located In	Corner Code #
1. Public Land Survey	T2N R6E	C-13
	T__ R__	_____
	T__ R__	_____
	T__ R__	_____
2. Property Controlling in Section	S__ T__ R__	_____
	S__ T__ R__	_____
3. Miscellaneous Property in Sec.	S__ T__ R__	_____
	S__ T__ R__	_____
4. Lot No. _____, Recorded Plat _____		
5. Private Claims _____		

L.S.C.#628m
REGISTER OF DEEDS STAMP & FILE NUMBER

	A	B	C	D	E	F	G	H	I	J	K	L	M
2	6	6	4	3	2	1							
3													
4	7	8	9	10	11	12							
5													
6	18	17	16	15	14	13							
7													
8	19	20	21	22	23	24							
9													
10	30	29	28	27	26	25							
11													
12	31	32	33	34	35	36							
13													

I, BRYAN L. BOSS in a field survey on NOVEMBER 4, 1996, do hereby certify that under requirements of P.A. 74, Michigan P.A. of 1970, the corner points mentioned in lines 1 and 2 above were in conformance with regulations and rules therefore as required in the current manual of survey instructions of the United States Department of the Interior, bureau of Land Management or by a decree of a Court of Law and/or that the corner points mentioned in lines 3, 4 and 5 above were in conformance with the rules of the Michigan Board of Land Surveyors or by a Decree of a Court of Law, established, re-established, monumented, re-monumented, recovered, found as expressed below:

NOTE: Not more than 4 corners, all in the same town and range, may be recorded on this certificate.

A. Description of original monument and accessories and/or subsequent restoration:

- CORNER SET BY ALEX HOLMES IN 1816
- WHITE OAK 20" N 67° E 89
- WHITE OAK 18" S 36° W 1.16
- WHITE OAK 7" S 59° E .70 - 1880 BULLOCK
- WHITE OAK 12" S 86° E 64.8
- WHITE OAK 10" N 27½° W 1.12 - 1886 TELLER


B. Description of corner evidence found and/or applied in restoring or reestablishing corner:

FOUND 1" INCH PIPE IN CONCRETE. THIS PIPE WAS SET IN 2' X 2' CONCRETE BY THE MICHIGAN DEPARTMENT OF TRANSPORTATION IN 1955.

C. Description of monument for corner and accessories established to perpetuate location the position of the corner:

SET BRASS CAP STAMPED "LIVINGSTON COUNTY MONUMENT CORNER" ON EXISTING PIPE IN CONCRETE.

- N 15° W NAIL & TAG EAST SIDE 28" OAK 18.65
- S 77° E NAIL & TAG SOUTH SIDE UTILITY POLE 17.74'
- N 25° E SOUTHEAST CORNER BUILDING 123.20'
- N 45° E NAIL & TAG SOUTH SIDE 10" OAK 185.76'
- S 15° W NAIL & TAG NORTH SIDE

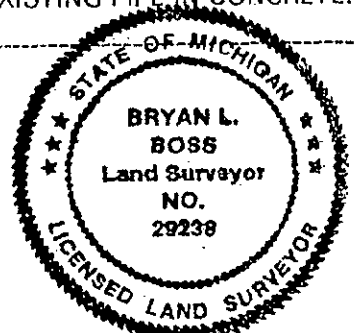

Signed by Bryan L. Boss
Surveyor's Michigan License No. 29238

Date 11-21-1996

FORM APPROVED BY MICHIGAN STATE BOARD OF LAND SURVEYORS, JAN. 28, 1971
REVISED MAY 14, 1975
REVISED JAN., 1983

PA. 345 1990, APPROVED BY LIVINGSTON COUNTY
PEER GROUP ON 8-28-96, CO. REP JED


0917

**SUMMARY
C-13**

Southwest Corner, Section 32, T2N-R6E, Brighton Township, Livingston County, Michigan.

Found 1" pipe in concrete. This corner was originally set by Alex Holmes in 1816 and later witnessed by Miles Bullock and J. Teller. The corner was again Monumented by M.D.O.T. in 1955, (see page 13 this dossier). A 1" pipe set in 2' x2' concrete was planted and has subsequently been used by others to this date. Only one comparison can be made on the distance sheet (page 6), but it is evident that all surveyors have utilized the same monument per witness sheet.

The corner is open for G.P.S. and we recommend it's acceptance as found.

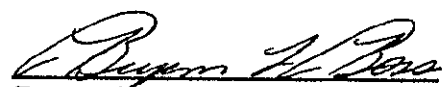
Bryan L. Boss No. 29238

