

4-  
FILED

LAND CORNER RECORDATION CERTIFICATE  
Filing Requirement of Act 74, Mich. P.A. 1970

For Corners in BRIGHTON TWP.

1996 DEC -3 P 3: 00K

NANCY HAVILAND  
REGISTER OF DEEDS  
LIVINGSTON COUNTY, MI.  
48843

L.S.C.#629m

REGISTER OF DEEDS STAMP & FILE NUMBER

LIVINGSTON  
(COUNTY)

Located In

Corner Code #

1. Public Land Survey

T2N R6E

D-11

T\_\_ R\_\_

T\_\_ R\_\_

T\_\_ R\_\_

2. Property Controlling  
in Section

S\_\_ T\_\_ R\_\_

S\_\_ T\_\_ R\_\_

3. Miscellaneous  
Property in Sec.

S\_\_ T\_\_ R\_\_

S\_\_ T\_\_ R\_\_

4. Lot No. \_\_\_\_\_, Recorded Plat \_\_\_\_\_

5. Private Claims \_\_\_\_\_

A B C D E F G H I J K L M

2	6	5	4	3	2	1
3						
4	7	8	9	10	11	12
5						
6	18	17	16	15	14	13
7						
8	19	20	21	22	23	24
9						
10	30	29	28	27	26	25
11						
12	31	32	33	34	35	36
13						

I, BRYAN L. BOSS in a field survey on NOVEMBER 1, 1996, do hereby certify that under requirements of P.A. 74, Michigan P.A. of 1970, the corner points mentioned in lines 1 and 2 above were in conformance with regulations and rules therefore as required in the current manual of survey instructions of the United States Department of the Interior, bureau of Land Management or by a decree of a Court of Law and/or that the corner points mentioned in lines 3, 4 and 5 above were in conformance with the rules of the Michigan Board of Land Surveyors or by a Decree of a Court of Law, established, re-established, monumented, re-monumented, recovered, found as expressed below:

NOTE: Not more than 4 corners, all in the same town and range, may be recorded on this certificate.

A. Description of original monument and accessories and/or subsequent restoration:

WHITE OAK 6" N 83½° E 1.10

BLACK OAK 6" N 83° W 1.21

BLACK OAK 16" S 85° W 70

YELLOW OAK 12" S 07° E 55

YELLOW OAK 10" S 84° W 71


B. Description of corner evidence found and/or applied in restoring or reestablishing corner:

FOUND 3/4" IRON PIPE IN CONCRETE MONUMENT IN A MONUMENT BOX. CLAY GORDON SURVEY ON JUNE 29, 1929 INDICATES CEMENT MONUMENT FOUND AT SOUTH ¼ POST, SECTION 29, AT INTERSECTION WALKER DRIVE AND LOCH LOMOND ROAD.

C. Description of monument for corner and accessories established to perpetuate location the position of the corner:

SET BRASS CAP STAMPED "LIVINGSTON COUNTY MONUMENT CORNER" ON EXISTING PIPE LOCATED IN A MONUMENT BOX.

NORTH NAIL & TAG WEST SIDE 52" OAK 43.17'  
S 65° E NAIL & TAG NORTHEAST SIDE UTILITY POLE 53.47'  
S 05° W NAIL & TAG EAST SIDE 14" OAK 44.44'  
N 50° W NAIL & TAG SOUTHWEST SIDE 4" OAK 60.0'

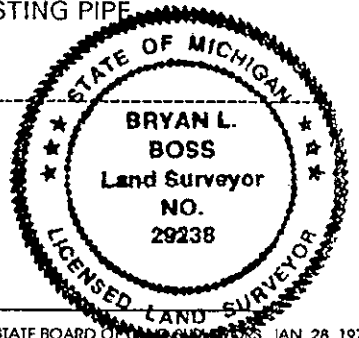

Signed by Bryan L. Boss

Date 11-21-1996

Surveyor's Michigan License No. 29238

FORM APPROVED BY MICHIGAN STATE BOARD OF LAND SURVEYORS, JAN. 28, 1971

REVISED MAY 14, 1975  
REVISED JAN., 1983

P.A. 345 1990, APPROVED BY LIVINGSTON COUNTY  
PEER GROUP ON 7-17-96 CO. REP JED

09.07

## SUMMARY


D-11

North ¼ Corner, Section 32, T2N-R6E, Brighton Township, Livingston County, Michigan

Found 3/4" iron pipe in concrete monument in a monument box 4 feet ± North of centerline Loch Lomond Road and 27 feet ± West of Centerline of Walker Drive. This monument box is 3 tenths ± below surface of gravel. The area is open for G.P.S. on June 29, 1929, Clay W. Gordon indicates on his survey CEM. MON. S¼ post, Section 29, at the intersection of Walker Drive and Loch Lomond Road.

The only M.D.O.T. witness remaining from their 6/3/57 records is North 30" Oak 43.26 feet, which checks out at North 52" Oak 43.17 feet. Please note they also found concrete monument. Witnesses by Boss Engineering in 1979 and 1981 call for found pipe in monument box.

In conclusion, we find the iron pipe in concrete in the monument box to be the same as noted by Clay Gordon on June 29, 1929, and recommend its acceptance.

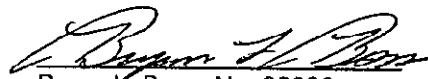  
Bryan L. Boss No. 29238

