

MAR 17 2000

FILED

SECTION

LAND CORNER RECORDATION CERTIFICATE
Filing Requirement of Act 74, Mich. P.A. 1970

1999 NOV 22 A 11:08

For corners in
LIVINGSTON
(County)

Located in: BRIGHTON Corner Code #

9

NANCY HAVILAND
REGISTER OF DEEDS
LIVINGSTON COUNTY, MI.
48843

1. Public Land Survey	T 2N	R 6E	E-9
	T	R	
	T	R	
	T	R	
2. Property Controlling in Section	S	T	R
	S	T	R
3. Miscellaneous Property in Sec.	S	T	R
	S	T	R

LSC# 1110m
Register of Deeds Stamp and File Number

4. Lot No. _____, Recorded Plat _____
5. Private Claims _____

I, Bryan L. Boss, in a field survey on NOV. 9, 1999

do hereby certify that under requirements of P.A. 74, Michigan P.A. of 1970, the corner points mentioned in lines 1 and 2 above were in conformance with regulations and rules therefor as required in the current manual of survey instructions of the United States Department of the Interior; Bureau of Land Management or by a decree of a Court of Law and/or that the corner points mentioned in lines 3,4 and 5 above were in conformance with the rules of the Michigan Board of Land Surveyors or by a Decree of a Court of Law; established, re-established, monumented, re-monumented, recovered, found as expressed below.

NOTE: Not more than 4 corners, all in the same town and range, may be recorded on this certificate.

A	B	C	D	E	F	G	H	I	J	K	L	M
2	6	5	4	3	2	1						
3												
4	7	8	9	10	11	12						
5												
6	18	17	16	15	14	13						
7												
8	19	20	21	22	23	24						
9												
10	30	29	28	27	26	25						
11												
12	31	32	33	34	35	36						
13												

A. Description of original monument and accessories and/or subsequent restoration:

SET POST
W. OAK 10" N28°E 1.24 CHAINS
W. OAK 12" S60°E 61 LINKS


B. Description of corner evidence found and/or method applied in restoring or reestablishing corner:

FOUND "MAG" NAIL
4.69' WEST OF EAST EDGE OF CONCRETE APRON ALONG EAST
SIDE OF OLD US. 23

C. Description of monument for corner and accessories established to perpetuate locating the position of the corner:

SET 1 1/4" X 30" PIPE CONNECTED BY PLASTIC
PIPE TO A 1 1/4" X 6" PIPE WITH BRASS CAP
STAMPED "LIVINGSTON COUNTY
REMONUMENTATION CORNER" IN A MON BOX
EAST 48.87' SET REMON NAIL/TAG S/S P. POLE
WEST 53.00' SET REMON NAIL/TAG N/S P. POLE
S85°W 53.79' SET REMON NAIL/TAG N/S 32"
POPLAR

N40°E 109.96' SET REMON ANIL/TAG W/S MULTI
STEM CHERRY
EAST 4.69' EDGE CONCRETE APRON

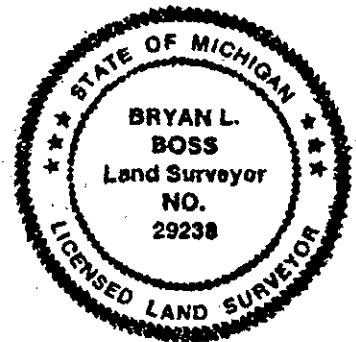

P.A. 345 1990, APPROVED BY LIVINGSTON COUNTY
PEER GROUP ON 6-10-99 CO. REP JED

Signed by Bryan L. Boss
Surveyor's Michigan License No. 29238

Date NOV. 11, 1999