

MAR 17 2000

FILED

SECTION

LAND CORNER RECORDATION CERTIFICATE
Filing Requirement of Act 74, Mich. P.A. 1970

For corners in
LIVINGSTON
(County)

Located in: BRIGHTON Corner Code #

1999 NOV 22 A 11: 08

NANCY HAVILAND
REGISTER OF DEEDS
LIVINGSTON COUNTY, MI.
48843

- | | | | |
|------------------------------------|------|------|------|
| 1. Public Land Survey | T 2N | R 6E | E-10 |
| | T | R | |
| | T | R | |
| | T | R | |
| 2. Property Controlling in Section | S | T | R |
| | S | T | R |
| 3. Miscellaneous Property in Sec. | S | T | R |
| | S | T | R |

LSC# 1111m
Register of Deeds Stamp and File Number

4. Lot No. _____, Recorded Plat. _____
5. Private Claims _____

I, Bryan L. Boss, in a field survey on OCT. 12, 1999
do hereby certify that under requirements of P.A. 74, Michigan P.A. of 1970, the corner points mentioned in lines 1 and 2 above were in conformance with regulations and rules therefor as required in the current manual of survey instructions of the United States Department of the Interior, Bureau of Land Management or by a decree of a Court of Law and/or that the corner points mentioned in lines 3, 4 and 5 above were in conformance with the rules of the Michigan Board of Land Surveyors or by a Decree of a Court of Law; established, re-established, monumented, re-monumented, recovered, found as expressed below.

A	B	C	D	E	F	G	H	I	J	K	L	M
2	6	5	4	3	2	1						
3												
4	7	8	9	10	11	12						
5												
6	18	17	16	15	14	13						
7												
8	19	20	21	22	23	24						
9												
10	30	29	28	27	26	25						
11												
12	31	32	33	34	35	36						
13												

NOTE: Not more than 4 corners, all in the same town and range, may be recorded on this certificate.

A. Description of original monument and accessories and/or subsequent restoration:


SET POST
6" BLACK OAK N33° W 33L.
6" BLACK OAK S79° E. 13L

B. Description of corner evidence found and/or method applied in restoring or reestablishing corner:

FOUND 1/2" IRON PIPE WITH UNREADABLE CAP

C. Description of monument for corner and accessories established to perpetuate locating the position of the corner:

SET 1 1/4" X 36" PIPE WITH BRASS CAP STAMPED
"LIVINGSTON COUNTY REMONUMENTATION
CORNER"
N 40° W 47.47' SET REMON N/T. W. SIDE 22" OAK
DUE EAST 52.30' SET REMON. N/T. S. SIDE GUY
POLE
S. 45° W 121.42' SET REMON N/T. E. SIDE P. POLE
DUE WEST 118.52' SET REMON. N/T. S. SIDE 27"
OAK
DUE SOUTH 24.86' CENTERLINE OF SPENCER
ROAD

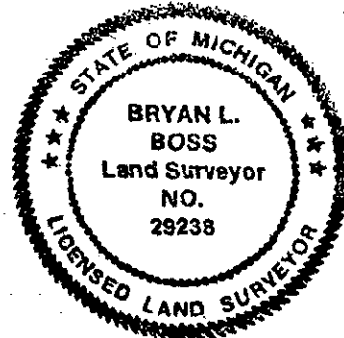

P.A. 345 1990, APPROVED BY LIVINGSTON COUNTY
PEER GROUP ON 7-21-99, CO. REP JED

Signed by Bryan L. Boss

Date NOV. 3 1999

Surveyor's Michigan License No. 29238