

MAR 17 2000

FILED

LAND CORNER RECORDATION CERTIFICATE
Filing Requirement of Act 74, Mich. P.A. 1970

SECTION

For corners in
LIVINGSTON
(County)

Located in: BRIGHTON Corner Code #

9

1999 NOV 22 A 11:08

NANCY HAVILAND
REGISTER OF DEEDS
LIVINGSTON COUNTY, MI.
48843

LSC# 1112m

Register of Deeds Stamp and File Number

- 1. Public Land Survey T 2N R 6E F-9
- 2. Property Controlling S T R
- 3. Miscellaneous S T R
- 5. Private Claims

I, Bryan L. Boss, in a field survey on 10-19-99
do hereby certify that under requirements of P.A. 74, Michigan P.A. of 1970, the corner points mentioned in lines 1 and 2 above were in conformance with regulations and rules therefor as required in the current manual of survey instructions of the United States Department of the Interior, Bureau of Land Management or by a decree of a Court of Law and/or that the corner points mentioned in lines 3, 4 and 5 above were in conformance with the rules of the Michigan Board of Land Surveyors or by a Decree of a Court of Law; established, re-established, monumented, re-monumented, recovered, found as expressed below.

NOTE: Not more than 4 corners, all in the same town and range, may be recorded on this certificate.

A. Description of original monument and accessories and/or subsequent restoration:

SET POST
6" TAMARACK N. 82° E 43 LINKS.
16" WHITE OAK S. 58° W 14 LINKS.


B. Description of corner evidence found and/or method applied in restoring or reestablishing corner:

FOUND 1 1/2" I. PIPE IN CENTERLINE OF BUNO ROAD

C. Description of monument for corner and accessories established to perpetuate locating the position of the corner:

SET 1 1/4" X 30" PIPE WITH PLASTIC INSERT
CONNECTED TO A 1 1/4" X 6" PIPE WITH BRASS
CAP STAMPED "LIVINGSTON COUNTY
REMONUMENTATION CORNER"
S05°E 35.37' SET REMON NAIL & TAG W/S 8"
CHERRY
S50°W 48.22' SET REMON NAIL & TAG N/S 16" OAK
N60°W 106.33' SET REMON NAIL & TAG S/SE 27"
OAK
S80°W 105.16' SET REMON NAIL & TAG N/S 14"
OAK

	A	B	C	D	E	F	G	H	I	J	K	L	M
2	6	5	4	3	2	1							
3													
4	7	8	9	10	11	12							
5													
6	18	17	16	15	14	13							
7													
8	19	20	21	22	23	24							
9													
10	30	29	28	27	26	25							
11													
12	31	32	33	34	35	36							
13													

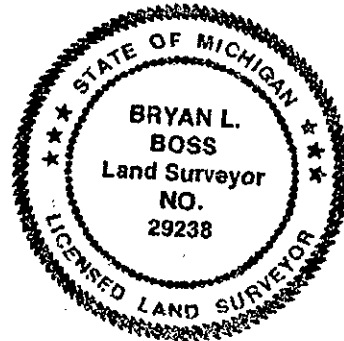

P.A. 345 1990, APPROVED BY LIVINGSTON COUNTY
PEER GROUP ON 6-16-99 CO. REP JED

Signed by [Signature]
Surveyor's Michigan License No. 29238

Date NOV 9, 1999