

SURVEY & REMONUMENTATION

FEB 25 1999

FILED

9-

LAND CORNER RECORDATION CERTIFICATE
Filing Requirement of Act 74, Mich. P.A. 1970

1998 OCT 27 P 2: 23

SECTION

For corners in

<u>Livingston</u> (County)	Located In:	Corner Code //
1. Public Land Survey	T <u>2N</u> R <u>6E</u>	<u>G-4</u>
	T _____ R _____	_____
	T _____ R _____	_____
	T _____ R _____	_____
2. Property Controlling in Section	S _____ T _____ R _____	_____
	S _____ T _____ R _____	_____
3. Miscellaneous Property in Sec.	S _____ T _____ R _____	_____
	S _____ T _____ R _____	_____
4. Lot No. _____, Recorded Plat _____		
5. Private Claims _____		

NANCY HAVILAND
REGISTER OF DEEDS
LIVINGSTON COUNTY, MI.
48843

LSC977M

Register of Deeds Stamp & File Number

I, Bryan L. BOSS, in a field survey on Oct. 7, 1998, do hereby certify that under requirements of P.A. 74, Michigan P.A. of 1970, the corner points mentioned in lines 1 and 2 above were in conformance with regulations and rules therefore as required in the current manual of survey instructions of the United States Department of the Interior, Bureau of Land Management or by a decree of a Court of Law and/or that the corner points mentioned in lines 3, 4 and 5 above were in conformance with the rules of the Michigan Board of Land Surveyors or by a Decree of a Court of Law; established, re-established, monumented, re-monumented, recovered, found as expressed below:

	A	B	C	D	E	F	G	H	I	J	K	L	M
2	6	5	4	3	2	1							
3													
4	7	8	9	10	11	12							
5													
6	18	17	16	15	14	13							
7													
8	19	20	21	22	23	24							
9													
10	30	29	28	27	26	25							
11													
12	31	32	33	34	35	36							
13													

NOTE: Not more than 4 corners, all in the same town and range, may be recorded on this certificate.

A. Description of original monument and accessories and/or subsequent restoration:

Set half mile post
Tamarack 6" S 55 E 2.48 chains
White Oak 20" N 03 W 3.2 chains


B. Description of corner evidence found and/or method applied in restoring or reestablishing corner:

Found 1/2" iron rod at intersection of Maxfield and Hyne Roads

PA. 345 1990, APPROVED BY LIVINGSTON COUNTY
PEER GROUP ON 8-19-98 CO. REP JED

C. Description of monument for corner and accessories established to perpetuate locating the position of the corner:

Set Monument box with 30" by 1 1/4" pipe with 6" breakaway and Brass cap stamped "Livingston County Remonumentation"
N 30 E 42.10 set Remon N/T Westside 44" Willow
S 30 E 31.85 set Remon N/T at South end 24" cmp
S 30 W 21.70 set Remon N/T of 2 post arrow sign
N 40 W 72.21 set Remon N/T Eastside power pole
West 10.50 found pk nail in centerline Hyne Road

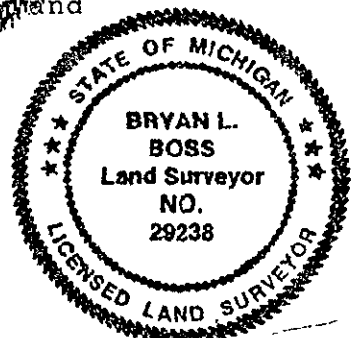

Signed by Bryan L. Boss Date 10-16-1998
Surveyor's Michigan License No. 29238