

SURVEY & REMONUMENTATION

FEB 25 1999

SECTION

LAND CORNER RECORDATION CERTIFICATE
Filing Requirement of Act 74, Mich. P.A. 1970

FILED

1998 OCT 27 P 2:23

NANCY HAVILAND
REGISTER OF DEEDS
LIVINGSTON COUNTY, MI.
48843

LSC978M

Register of Deeds Stamp & File Number

For corners in

Livingston
(County)

Located In:

Corner Code //

1. Public Land Survey	T <u>2N</u> R <u>6E</u>	<u>G-5</u>
	T _____ R _____	_____
	T _____ R _____	_____
	T _____ R _____	_____
2. Property Controlling in Section	S _____ T _____ R _____	_____
	S _____ T _____ R _____	_____
3. Miscellaneous Property in Sec.	S _____ T _____ R _____	_____
	S _____ T _____ R _____	_____

4. Lot No. _____, Recorded Plat _____

5. Private Claims _____

I, Bryan L. Boss, in a field survey on September 25, 19 98, do hereby certify that under requirements of P.A. 74, Michigan P.A. of 1970, the corner points mentioned in lines 1 and 2 above were in conformance with regulations and rules therefore as required in the current manual of survey instructions of the United States Department of the Interior, Bureau of Land Management or by a decree of a Court of Law and/or that the corner points mentioned in lines 3, 4 and 5 above were in conformance with the rules of the Michigan Board of Land Surveyors or by a Decree of a Court of Law; established, re-established, monumented, re-monumented, recovered, found as expressed below:

NOTE: Not more than 4 corners, all in the same town and range, may be recorded on this certificate.

A. Description of original monument and accessories and/or subsequent restoration:

Set corner post (,19,15,16,)
N Oak 30 N 15 E 6 links
Elm 6" S 15 W 21 links


B. Description of corner evidence found and/or method applied in restoring or reestablishing corner:

Found 1½" pipe 1' below grade on Easterly edge of drive

PA. 345 1990, APPROVED BY LIVINGSTON COUNTY
PEER GROUP ON 8-1998 CO. REP JED

C. Description of monument for corner and accessories established to perpetuate locating the position of the corner:

Set 1½" by 36" pipe with Brass cap stamped "Livingston County Remonumentation"
N 80 E 29.46 set Remon N/T Southside 16" Hickory
North 8.14 set Remon N/T 30" Maple
S 70 W 56.47 set Remon N/T Northside power pole
S 40 E 62.81 set Remon N/T Northside 12" Cherry

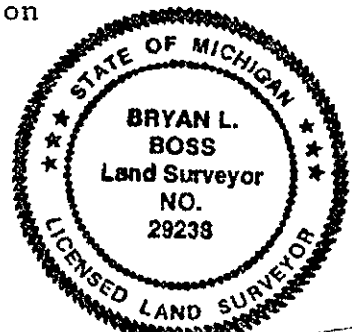

Signed by Bryan L. Boss

Date 10-16-1998

Surveyor's Michigan License No. 29238

