

FEB 25 1999

SECTION

LAND CORNER RECORDATION CERTIFICATE  
Filing Requirement of Act 74, Mich. P.A. 1970

FILED

1998 OCT 27 P 2:23

NANCY HAVILAND  
REGISTER OF DEEDS  
LIVINGSTON COUNTY, MI.  
48843

LSC979M

Register of Deeds Stamp & File Number

For corners in  
Livingston  
(County)

Located In:	Corner Code //
T <u>2N</u> R <u>6E</u>	<u>G-6</u>
T _____ R _____	_____
T _____ R _____	_____
T _____ R _____	_____
S _____ T _____ R _____	_____
S _____ T _____ R _____	_____
S _____ T _____ R _____	_____
S _____ T _____ R _____	_____

- Public Land Survey
- Property Controlling in Section
- Miscellaneous Property in Sec.

- Lot No. \_\_\_\_\_, Recorded Plat \_\_\_\_\_
- Private Claims \_\_\_\_\_

	A	B	C	D	E	F	G	H	I	J	K	L	M
2	6	5	4	3	2	1							
3													
4	7	8	9	10	11	12							
5													
6	18	17	16	15	14	13							
7													
8	19	20	21	22	23	24							
9													
10	30	29	28	27	26	25							
11													
12	31	32	33	34	35	36							
13													

I, Bryan L. Boss, in a field survey on Oct. 7, 19 98, do hereby certify that under requirements of P.A. 74, Michigan P.A. of 1970, the corner points mentioned in lines 1 and 2 above were in conformance with regulations and rules therefore as required in the current manual of survey instructions of the United States Department of the Interior, Bureau of Land Management or by a decree of a Court of Law and/or that the corner points mentioned in lines 3, 4 and 5 above were in conformance with the rules of the Michigan Board of Land Surveyors or by a Decree of a Court of Law; established, re-established, monumented, re-monumented, recovered, found as expressed below:

NOTE: Not more than 4 corners, all in the same town and range, may be recorded on this certificate.

A. Description of original monument and accessories and/or subsequent restoration:

Set half mile post  
White Oak 20" S 5 SW 16 links  
White Oak 30" N 11 E 41 links


B. Description of corner evidence found and/or method applied in restoring or reestablishing corner:

Found 1/2" iron rod 1' east of Asphalt Drive

P.A. 245 1990, APPROVED BY LIVINGSTON COUNTY  
PEER GROUP ON 9-2-98 CO. REP JED

C. Description of monument for corner and accessories established to perpetuate locating the position of the corner:

Set 1 1/4" by 36" pipe with Brass cap stamped "Livingston County Remonumentation"  
Northj 21/09 set Remon N/T Westside 42" Walnut  
N 60 E 31.83 set Remon N/T Southside 10" Elm  
S 30 W 61.13 set Remon N/T Eastside 18" Walnut  
West 57.12 set Remon N/T Southside 20" Walnut

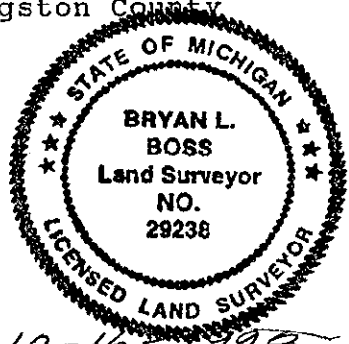

Signed by [Signature]  
Surveyor's Michigan License No. 29238

Date 10-16-1998