

OCT 26 1995

COMMISSION

LAND CORNER RECORDATION CERTIFICATE  
Filing Requirement of Act 74, Mich. P.A. 1970

NANCY HAVILLAND  
REGISTER OF DEEDS  
LIVINGSTON COUNTY, MI  
48843

OCT 4 3 18 PM '95

FILED

For corners in

Livingston (County)	Located In:	Corner Code ##
1. Public Land Survey	T 2N R 6E	G-9
	T _____ R _____	_____
	T _____ R _____	_____
	T _____ R _____	_____
2. Property Controlling in Section	S _____ T _____ R _____	_____
	S _____ T _____ R _____	_____
3. Miscellaneous Property in Sec.	S _____ T _____ R _____	_____
	S _____ T _____ R _____	_____

L.S.C.#442m

Register of Deeds Stamp & File Number

- 4. Lot No. \_\_\_\_\_, Recorded Plat \_\_\_\_\_
- 5. Private Claims \_\_\_\_\_

	A	B	C	D	E	F	G	H	I	J	K	L	M
2	6		5		4		3		2		1		
3													
4	7		8		9		10		11		12		
5													
6	18		17		16		15		14		13		
7													
8	19		20		21		22		23		24		
9													
10	30		29		28		27		26		25		
11													
12	31		32		33		34		35		36		
13													

I, Bryan Ross, in a field survey on 9-6, 19 95, do hereby certify that under requirements of P.A. 74, Michigan P.A. of 1970, the corner points mentioned in lines 1 and 2 above were in conformance with regulations and rules therefore as required in the current manual of survey instructions of the United States Department of the Interior, Bureau of Land Management or by a decree of a Court of Law and/or that the corner points mentioned in lines 3, 4 and 5 above were in conformance with the rules of the Michigan Board of Land Surveyors or by a Decree of a Court of Law; established, re-established, monumented, re-monumented, recovered, found as expressed below:

NOTE: Not more than 4 corners, all in the same town and range, may be recorded on this certificate.

A. Description of original monument and accessories and/or subsequent restoration:


- Set post corner to Section 21, 22, 27, & 28
- White Oak 10" N 52 E 75 links
- White Oak 10" S 25 W 40 links
- Maple 4" N 62 W 79

B. Description of corner evidence found and/or method applied in restoring or reestablishing corner:

- 1/2" iron found in monument box at centerline
- Buno Road and centerline Van Amberg Road.
- 63.75' N 15° W spike West side power pole
- 68.65' N 30° E spike West side power pole
- 59.00' N 70° E Southwest corner Michigan Bell box
- (Livingston County Road Commission field notes).

C. Description of monument for corner and accessories established to perpetuate locating the position of the corner:

- Set brass cap on 1/2" iron in monument box
- 64.52' N 25° W nail & tag East side power pole
- 69.38' N 20° E nail & tag Southeast side power pole
- 107.70' N 80° E nail & tag South side 18" apple
- 47.59' S 75° E nail & tag West side power pole
- 47.93' S 85° W stop sign post

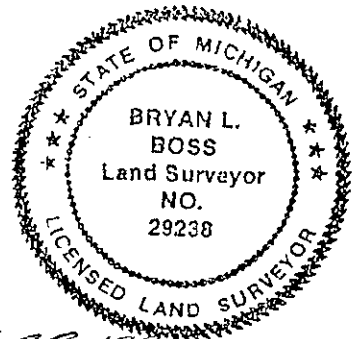

Signed by Bryan L. Boss Date Sept. 28, 1995  
 Surveyor's Michigan License No. 29238

SUMMARY

G-9

Northwest Corner, Section 27, T2N-R6E, Brighton Township, Livingston County, Michigan.

Found 1/2" iron rod in monument box at centerline of Buno Road and centerline of Van Amberg Road. This corner open for G.P.S. and found no evidence of multiple corner.


Distances on Section lines North, South, East and West are consistent and tolerable among seven surveyors (page 6 this dossier). Only one witness (18" apple in N.E. Quadrant) was found from Robert Jagow's 7-27-72 survey; found by Charles Garlock on April 29, 1991 survey (page 29 this dossier) and found by Washtenaw Engineering, 6-24-86 (page 26).

L.C.R.C survey notes (pages 24 & 25) of this dossier has distances that check with previous surveys (page 6) and also has one witness consistent with previous recorded surveys. This appears to be the one and only location for the remonumented corner.

Field verification of existing corner was performed on 3-20-95 per Peer Group instructions (see pages 35, 36 & 37).

Conclusion: We find the 1/2" iron rod in monument box should be accepted as found.

BRIG-9S

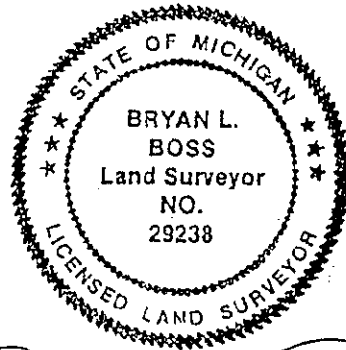

A handwritten signature in cursive script, appearing to read "Bryan L. Boss", written over the bottom portion of the professional seal.