

SURVEY & REMONUMENTATION

FEB 25 1999

FILED November 17, 1998

AT 10:55 O'CLOCK A.M.

SECTION

NANCY HAVILAND
REGISTER OF DEEDS
LIVINGSTON COUNTY
Filing Requirement of Act 74, Mich. P.A. 1970

~~NOV 20 1998~~

For corners in
Livingston
(County)

Located In: Corner Code //

1. Public Land Survey	T	2N	R	6E	H-5
	T		R		
	T		R		
	T		R		
2. Property Controlling in Section	S		T	R	
	S		T	R	
3. Miscellaneous Property in Sec.	S		T	R	
	S		T	R	

NANCY HAVILAND
REGISTER OF DEEDS
LIVINGSTON COUNTY, MI.
48843

L.S.C.#985m

~~E.S.C.#1850~~

Register of Deeds Stamp & File Number

4. Lot No. _____, Recorded Plat _____
5. Private Claims _____

I, Bryan L. Boss, in a field survey on Oct 7, 1998, do hereby certify that under requirements of P.A. 74, Michigan P.A. of 1970, the corner points mentioned in lines 1 and 2 above were in conformance with regulations and rules therefore as required in the current manual of survey instructions of the United States Department of the Interior, Bureau of Land Management or by a decree of a Court of Law and/or that the corner points mentioned in lines 3, 4 and 5 above were in conformance with the rules of the Michigan Board of Land Surveyors or by a Decree of a Court of Law; established, re-established, monumented, re-monumented, recovered, found as expressed below:

NOTE: Not more than 4 corners, all in the same town and range, may be recorded on this certificate.

A. Description of original monument and accessories and/or subsequent restoration:

White Oak 10" S 81 W 20 links
Black Oak 10" N 4½ E 83 links

B. Description of corner evidence found and/or method applied in restoring or reestablishing corner:


Found pipe with capped #19005

C. Description of monument for corner and accessories established to perpetuate locating the position of the corner:

Set 1½" by 36" pipe with Brass cap Stamped "Livingston County Remonumentation"
N 50 W 11.64 set Remon N/T NE/S 14" Oak
N 40 E 47.73 set Remon N/T NW/S twin 9" Oak
S 40 E 21.73 set Remon N/T W/S 16" Oak
S 50 W 34.06 set Remon N/T SE/S 10" Oak
West 1.0' Fd Nail in post

	A	B	C	D	E	F	G	H	I	J	K	L	M
2	6		5		4		3		2		1		
3													
4	7		8		9		10		11		12		
5													
6	18		17		16		15		14		13		
7													
8	19		20		21		22		23		24		
9													
10	30		29		28		27		26		25		
11													
12	31		32		33		34		35		36		
13													

PA. 345 1990, APPROVED BY LIVINGSTON COUNTY
PEER GROUP ON 9-2-98 CO. REP JED

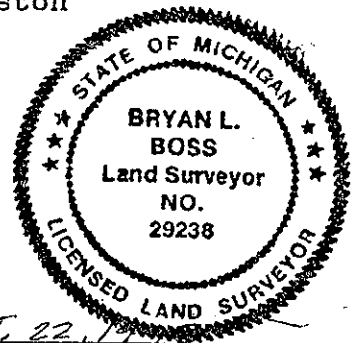

Signed by Bryan L. Boss Date Oct. 22, 1998
Surveyor's Michigan License No. 29238