

OCT 26 1995

COMMISSION

LAND CORNER RECORDATION CERTIFICATE
Filing Requirement of Act 74, Mich. P.A. 1970

900

OCT 6 11 58 AM 1995
FILED
NANCY HAVILINE
REGISTER OF DEEDS
LIVINGSTON COUNTY, MICH.
ADDRESS

L.S.C. #449m
Register of Deeds Stamp & File Number

For corners in Livingston

(County)	Located In:	Corner Code #
1. Public Land Survey	T ^{2N} R ^{6E}	H-11
	T _____ R _____	_____
	T _____ R _____	_____
	T _____ R _____	_____
2. Property Controlling in Section	S _____ T _____ R _____	_____
	S _____ T _____ R _____	_____
3. Miscellaneous Property in Sec.	S _____ T _____ R _____	_____
	S _____ T _____ R _____	_____

4. Lot No. _____, Recorded Plat _____
5. Private Claims _____

I, Bryan Boss, in a field survey on 9-6, 1995, do hereby certify that under requirements of P.A. 74, Michigan P.A. of 1970, the corner points mentioned in lines 1 and 2 above were in conformance with regulations and rules therefore as required in the current manual of survey instructions of the United States Department of the Interior, Bureau of Land Management or by a decree of a Court of Law and/or that the corner points mentioned in lines 3, 4 and 5 above were in conformance with the rules of the Michigan Board of Land Surveyors or by a Decree of a Court of Law; established, re-established, monumented, re-monumented, recovered, found as expressed below:


	A	B	C	D	E	F	G	H	I	J	K	L	M
2	6	5	4	3	2								
3													
4	7	8	9	10	11	12							
5													
6	18	17	16	15	14	13							
7													
8	19	20	21	22	23	24							
9													
10	30	29	28	27	26	25							
11													
12	31	32	33	34	35	36							
13													

NOTE: Not more than 4 corners, all in the same town and range, may be recorded on this certificate.

A. Description of original monument and accessories and/or subsequent restoration:
White Oak 26" S 81° E 1.65 chains
White Oak 24" N 72° W 3.54 chains
Black Oak 17" S 16° W 57 links
Elm 24" N 45° E 45 feet
White Oak 24" S 60° W 42 feet

B. Description of corner evidence found and/or method applied in restoring or reestablishing corner:
3/4" iron pipe found in asphalt apron to Van Amberg Road on centerline Van Amberg Road and 12 feet ± west of centerline Pleasant Valley Road on curve
N 30° E 78.5' 36" Oak
N 60° W 30.8' 24" Oak
S 60° W 42.1' 30" Oak

C. Description of monument for corner and accessories established to perpetuate locating the position of the corner:
Set brass cap in iron in monument box
30.78' N 75° W nail & tag 30" Oak
42.12' S 20° W nail & tag 28" Oak
119.53' S 40° E nail & tag west side 12" Walnut
79.03' N 20° E nail & tag northwest side 42" Oak

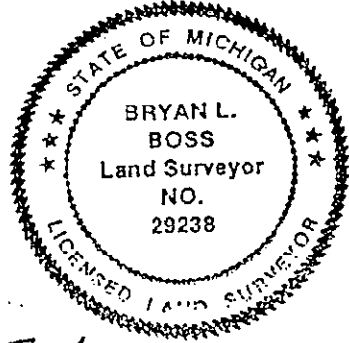

Signed by Bryan L. Boss Date Oct. 4, 1995
Surveyor's Michigan License No. 29238

SUMMARY
H-11

North $\frac{1}{4}$ Corner, Section 34, T2N-R6E, Brighton Township, Livingston County, Michigan.

Found $\frac{3}{4}$ " iron pipe in asphalt pavement in the C/L of VanAmburg Road and is 12 feet \pm West of centerline of Pleasant Valley Road, which is on a curve. Established GPS is possible, some overhanging branches.

On July 25, 1951, Clay Gordon new witnesses for South $\frac{1}{4}$ Corner of Section 27 (see page 13 this dossier). On April 26, 1965, Charles Garlock found two of these witnesses and reset spike on third witness tree, page 16. Witness sheet on page 7 substantiates two of Clay Gordon's witnesses were found in 1993 by Jennifer Defenderfer and a third witness set in 1966, page 17 also checked Boss Engineering witness sheet on page 35.

There are four Act 74's on record for this corner. 1972, 1973, 1986 and 1993. All three witness the same point and match the 1951 Clay Gordon witness.

Conclusion:

We find the $\frac{3}{4}$ " pipe found on 1-25-1995 to be at same location as found by Clay Gordon in 1951 and recommend its acceptance as the North $\frac{1}{4}$ Corner of Section 34 (H-11).

BRIH-11S



Bryan L. Boss