

**SURVEY & REMONUMENTATION**

FEB 25 1999

9-  
**FILED**

**SECTION**

**LAND CORNER RECORDATION CERTIFICATE**  
Filing Requirement of Act 74, Mich. P.A. 1970

1998 OCT 27 P 2: 23

For corners in

<u>Livingston</u> <small>(County)</small>	Located In:	Corner Code //
1. Public Land Survey	T <u>2N</u> R <u>6E</u>	<u>T-4</u>
	T _____ R _____	_____
	T _____ R _____	_____
	T _____ R _____	_____
2. Property Controlling in Section	S _____ T _____ R _____	_____
	S _____ T _____ R _____	_____
3. Miscellaneous Property in Sec.	S _____ T _____ R _____	_____
	S _____ T _____ R _____	_____

NANCY HAVILAND  
REGISTER OF DEEDS  
LIVINGSTON COUNTY, MI.  
48843

LSC982M

Register of Deeds Stamp & File Number

4. Lot No. \_\_\_\_\_, Recorded Plat \_\_\_\_\_  
5. Private Claims \_\_\_\_\_

A	B	C	D	E	F	G	H	I	J	K	L	M
2	6	5	4	3	2	1						
3												
4	7	8	9	10	11	12						
5												
6	18	17	16	15	14	13						
7												
8	19	20	21	22	23	24						
9												
10	30	29	28	27	26	25						
11												
12	31	32	33	34	35	36						
13												

I, Bryan L. BOSS, in a field survey on Sept. 25, 1998, do hereby certify that under requirements of P.A. 74, Michigan P.A. of 1970, the corner points mentioned in lines 1 and 2 above were in conformance with regulations and rules therelore as required in the current manual of survey instructions of the United States Department of the Interior, Bureau of Land Management or by a decree of a Court of Law and/or that the corner points mentioned in lines 3, 4 and 5 above were in conformance with the rules of the Michigan Board of Land Surveyors or by a Decree of a Court of Law; established, re-established, monumented, re-monumented, recovered, found as expressed below:

**NOTE: Not more than 4 corners, all in the same town and range, may be recorded on this certificate.**

A. Description of original monument and accessories and/or subsequent restoration:

Set post 1823  
White Oak 10" N 86 E 1.68 chain  
White Oak 14" S 83 W 87 Link


B. Description of corner evidence found and/or method applied in restoring or reestablishing corner:

Found 1/2" iron rod 4.5 North of centerline Hyne Rd.

P.A. 345 1990, APPROVED BY LIVINGSTON COUNTY  
PEER GROUP ON 9-2-98 CO. REP JED

C. Description of monument for corner and accessories established to perpetuate localing the position of the corner:

Set Mon. box with 30" by 1 1/4" pipe with 6" breakaway and Brass cap stamped "Livingston County Remonumentation"  
N 30 E 37.09 set Remon N/T Southeast side 10" Hickory  
N 78 E 81.18 set Remon N/T Southside 12" & 15" double Oak  
S 45 E 80.30 set Remon N/T Northeast side 14" Oak  
S 20 E 34.02 set Remon N/T Southwest side 15" Oak

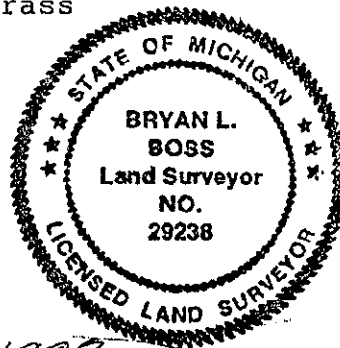

Signed by [Signature] Date 10-16-1998  
Surveyor's Michigan License No. 29238