

FEB 25 1999

SECTION

LAND CORNER RECORDATION CERTIFICATE
Filing Requirement of Act 74, Mich. P.A. 1970

FILED

1998 OCT 27 P 2: 24

For corners in

Livingston <small>County</small>	Located In:	Corner Code //
1 Public Land Survey	1 <u>2N</u> R <u>6E</u>	<u>I-5</u>
	T <u> </u> R <u> </u>	_____
	T <u> </u> R <u> </u>	_____
	T <u> </u> R <u> </u>	_____
2. Property Controlling in Section	S <u> </u> T <u> </u> R <u> </u>	_____
	S <u> </u> T <u> </u> R <u> </u>	_____
3. Miscellaneous Property in Sec.	S <u> </u> T <u> </u> R <u> </u>	_____
	S <u> </u> T <u> </u> R <u> </u>	_____

NANCY HAVILAND
REGISTER OF DEEDS
LIVINGSTON COUNTY, MI.
48843

LSC983M

Register of Deeds Stamp & File Number

- 4. Lot No. _____, Recorded Plat _____
- 5. Private Claims _____

A	B	C	D	E	F	G	H	I	J	K	L	M
2	6	5	4	3	2	1						
3												
4	7	8	9	10	11	12						
5												
6	18	17	16	15	14	13						
7												
8	19	20	21	22	23	24						
9												
10	30	29	28	27	26	25						
11												
12	31	32	33	34	35	36						
13												

I, Bryan L. Boss, in a field survey on Oct. 2, 1998, do hereby certify that under requirements of P.A. 74, Michigan P.A. of 1970, the corner points mentioned in lines 1 and 2 above were in conformance with regulations and rules therefore as required in the current manual of survey instructions of the United States Department of the Interior, Bureau of Land Management or by a decree of a Court of Law and/or that the corner points mentioned in lines 3, 4 and 5 above were in conformance with the rules of the Michigan Board of Land Surveyors or by a Decree of a Court of Law; established, re-established, monumented, re-monumented, recovered, found as expressed below:

NOTE: Not more than 4 corners, all in the same town and range, may be recorded on this certificate.

A. Description of original monument and accessories and/or subsequent restoration:

Set by Sibley
10" Black Oak N 10.69cH
10" White Oak S 1 W 4.91cH

3. Description of corner evidence found and/or method applied in restoring or reestablishing corner:


1/2 iron found

P.A. 345 1990, APPROVED BY LIVINGSTON COUNTY
PEER GROUP ON 9-16-98 CO. REP JED

2. Description of monument for corner and accessories established to perpetuate locating the position of the corner:

Set 1 1/4" by 36" Iron and pipe with a Brass cap stamped "Livingston County Monumentation Corner" left 6" above grade

S 70 E N/T South side of 24" Locust 19.07
S 10 W N/T West side of 28" Oak 38.25
N 66 W N/T North side of 24" Oak 22.21
N 10 E N/T west side of 14" Oak 18.60

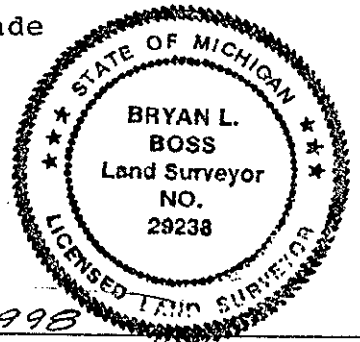

Signed by Bryan L. Boss
Surveyor's Michigan License No. 29238

Date 10-15-1998