

SURVEY & REMONUMENTATION

FEB 25 1999

SECTION

LAND CORNER RECORDATION CERTIFICATE
Filing Requirement of Act 74, Mich. P.A. 1970

9-
FILED

1998 OCT 27 P 2: 24

For corners in

Livingston
County

Located in:

Corner Code //

- 1. Public Land Survey T 2N R 6E I-6
- I R
- I R
- T R
- 2. Property Controlling S T R
- in Section S T R
- 3. Miscellaneous S T R
- Property in Sec. S T R

NANCY HAVILAND
REGISTER OF DEEDS
LIVINGSTON COUNTY, MI.
48843

LSC984M

Register of Deeds Stamp & File Number

- 4. Lot No. _____, Recorded Plat _____
- 5. Private Claims _____

	A	B	C	D	E	F	G	H	I	J	K	L	M
2	6		5		4		3		2		1		
3													
4	7		8		9		10		11		12		
5													
6	18		17		16		15		14		13		
7													
8	19		20		21		22		23		24		
9													
10	30		29		28		27		26		25		
11													
12	31		32		33		34		35		36		
13													

I, Byran L. Boss, in a field survey on September 25, 1998, do hereby certify that under requirements of P.A. 74, Michigan P.A. of 1970, the corner points mentioned in lines 1 and 2 above were in conformance with regulations and rules therefore as required in the current manual of survey instructions of the United States Department of the Interior, Bureau of Land Management or by a decree of a Court of Law and/or that the corner points mentioned in lines 3, 4 and 5 above were in conformance with the rules of the Michigan Board of Land Surveyors or by a Decree of a Court of Law; established, re-established, monumented, re-monumented, recovered, found as expressed below:

NOTE: Not more than 4 corners, all in the same town and range, may be recorded on this certificate.

A. Description of original monument and accessories and/or subsequent restoration:

- White Oak 14" N 34 E 1.11 chains
- Black Oak 13" S 24 W 1.77 chains


3. Description of corner evidence found and/or method applied in restoring or reestablishing corner:

Found 1/2" iron rod 0.5 feet West of gravel drive

PA. 345 1990, APPROVED BY LIVINGSTON COUNTY
PEER GROUP ON 9-16-98 CO. REP JED

B. Description of monument for corner and accessories established to perpetuate locating the position of the corner:

Set 1 1/4" by 30" pipe with 6" breakaway & Brass cap Stamped
"Livingston County Monumentation Corner"
N 25 E 34.66 N/T West side 12" triple poplar
West 7.35 N/T Northside 5" poplar
S 75 E 83.91 N/T Southside 18" triple poplar
S 40 E 97.93 N/T Southwest side 10" Quad poplar
(E 6.37' Fd. 1/2" IRON ROD)

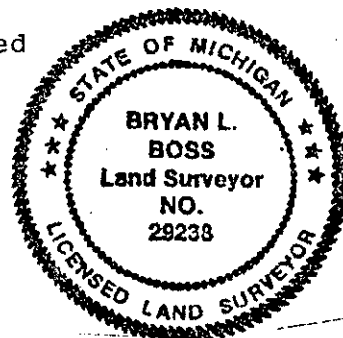

Signed by Bryan L. Boss

Date 10-16-1998

Surveyor's Michigan License No. 29238