

**SURVEY &
REMONUMENTATION**

FILED

APR 28 1995

LAND CORNER RECORDATION CERTIFICATE
Filing Requirement of Act 74, Mich. P.A. 1970

Nov 16 11 03 AM '94

COMMISSION

NANCY HAVILAND
REGISTER OF DEEDS
LIVINGSTON COUNTY, MI.
48843

For corners in
Livingston
(County)

Located In: Corner Code #

- | | | |
|---------------------------------------|-------------------------|-------------|
| 1. Public Land Survey | T <u>2N</u> R <u>6E</u> | <u>I-10</u> |
| | T _____ R _____ | _____ |
| | T _____ R _____ | _____ |
| | T _____ R _____ | _____ |
| 2. Property Controlling
In Section | S _____ T _____ R _____ | _____ |
| | S _____ T _____ R _____ | _____ |
| 3. Miscellaneous
Property in Sec. | S _____ T _____ R _____ | _____ |
| | S _____ T _____ R _____ | _____ |

L.S.C.#312m

Register of Deeds Stamp & File Number

4. Lot No. _____, Recorded Plat _____
5. Private Claims _____

	A	B	C	D	E	F	G	H	I	J	K	L	M
2	6		5		4		3		2		1		
3													
4	7		8		9		10		11		12		
5													
6	18		17		16		15		14		13		
7													
8	19		20		21		22		23		24		
9													
10	30		29		28		27		26		25		
11													
12	31		32		33		34		35		36		
13													

I, Bryan Boss, in a field survey on 10-27, 19 94, do hereby certify that under requirements of P.A. 74, Michigan P.A. of 1970, the corner points mentioned in lines 1 and 2 above were in conformance with regulations and rules therefore as required in the current manual of survey instructions of the United States Department of the Interior, Bureau of Land Management or by a decree of a Court of Law and/or that the corner points mentioned in lines 3, 4 and 5 above were in conformance with the rules of the Michigan Board of Land Surveyors or by a Decree of a Court of Law; established, re-established, monumented, re-monumented, recovered, found as expressed below:

NOTE: Not more than 4 corners, all in the same town and range, may be recorded on this certificate.

A. Description of original monument and accessories and/or subsequent restoration:

- Black Oak 6" N 53 E 6 Links
- Black Oak 10" S 10 W 20 Links

ADDITIONAL HISTORICAL DATA ON BACK OF SHEET


B. Description of corner evidence found and/or method applied in restoring or reestablishing corner:

Found 1/2" inch iron rod 2 feet South of South edge private drive (Blossom Lane) and 58' feet ± West of centerline private drive and Spencer Road.

C. Description of monument for corner and accessories established to perpetuate localing the position of the corner:

Set 1 1/4" x 36" iron pipe with brass cap marked Livingston County Monument Corner.

- West 65.71' N/T 6" Poplar
- North 35.74' N/T Twin 10" Cherry
- South 41.62' N/T 14" Oak
- S80°E 44.25' N/T 10" Hickory

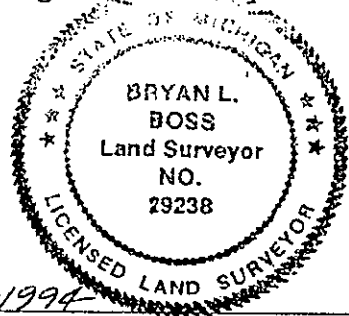

Signed by [Signature]
Surveyor's Michigan License No. 29238

Date 11-10-1994

T2N-R6E I-10 Page 1

BOSS ENGINEERING ENGINEERS & SURVEYORS

SUMMARY I-10

WEST 1/4 CORNER, SECTION 26, T2N-R6E BRIGHTON TOWNSHIP, LIVINGSTON COUNTY, MICHIGAN.

Found 1/2" inch Iron Rod 1 foot \pm below grade, 2' feet South of South edge Private Drive (Blossom Lane) and 58' feet \pm West of Centerline Private Drive and Spencer Road.

Township originally Surveyed by Alex Holmes, in 1815. Sections Surveyed in 1823 by Sylvester Sibley.


Measured to Witnesses found. No Witnesses found on Boss Engineering Surveys pages 11, 12 found 1 of 3 Boss Witnesses page 20 and it checked. Found 1 of 3 Albright Witnesses page 13, 14, 15, 18 and it checked. Found 1 of 5 Munsell & Garlock Witnesses page 21 and 1 of 5 Charles Garlock Witnesses page 27 and it checked. Found 3 of 3 Boss Engineering Witnesses pages 24, 26 and they checked. Also, found 2 of 4 Darrell Hughes Witnesses they checked.

Distances from the West 1/4 Corner of Section 26 to the Center of said Section is 2630.91' feet John Albright Survey page 18 this Dossier; 2630.91' feet page 19; 2630.79' feet page 23; 2630.72' feet page 25 Boss Engineering Surveys; 2630.80' feet Darrell Hughes Survey page 29 this Dossier.

Distance from the West 1/4 Corner Section 26 Westerly to the East 1/8 line of Section 27 is 1299.6' feet Russell Cole Survey page 9 this Dossier; 1300.2' feet Boss Engineering Survey page 16, 17 of this Dossier; 1298.46' feet Munsell & Garlock Surveys, pages 21, 22, 27, 28 this Dossier.

Distance from the Southwest Corner of Section 26 to the West 1/4 Corner of said Section is 2691.32' feet Boss Engineering Survey page 25 this Dossier; and 2691.32' feet Darrell Hughes Survey page 29 this Dossier. This area is heavily wooded and will be a difficult G.P.S. Corner.

Conclusion: We have evidence that 5 Surveyors measured East between 2630.72 and 2630.91' feet; West 1298.46' feet to 1300.2' feet; and South 1346.53' feet to 1349.1' feet. Therefore, we recommend accepting the 1/2" Iron Rod as the West 1/4 Corner of Section 26.

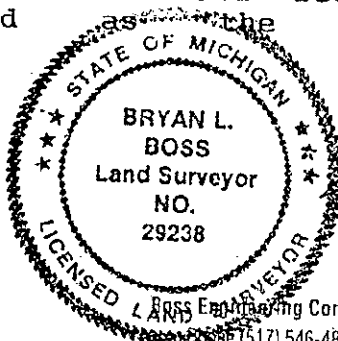

Bryan L. Boss

file:summl7