

FILED

DEC 28 4 17 PM '93

LAND CORNER RECORDATION CERTIFICATE  
Filing Requirement of Act 74, Mich. P.A. 1970

For corners in

Livingston  
County

Located In: 2 N 6 E pm Corner Code #

- 1. Public Land Survey T 1N R 5E K-11  
T \_\_\_\_\_ R \_\_\_\_\_  
T \_\_\_\_\_ R \_\_\_\_\_ Seg. #1 NW  
T \_\_\_\_\_ R \_\_\_\_\_
- 2. Property Controlling S \_\_\_\_\_ T \_\_\_\_\_ R \_\_\_\_\_  
in Section S \_\_\_\_\_ T \_\_\_\_\_ R \_\_\_\_\_
- 3. Miscellaneous S \_\_\_\_\_ T \_\_\_\_\_ R \_\_\_\_\_  
Property in Sec. S \_\_\_\_\_ T \_\_\_\_\_ R \_\_\_\_\_

NANCY HAVILAND  
REGISTER OF DEEDS  
LIVINGSTON COUNTY, MI  
48843

L.S.C. #131m  
Register of Deeds Stamp & File Number

- 4. Lot No. \_\_\_\_\_, Recorded Plat \_\_\_\_\_
- 5. Private Claims \_\_\_\_\_

	A	B	C	D	E	F	G	H	I	J	K	L	M
2	6		5		4		3		2		1		
3													
4	7		8		9		10		11		12		
5													
6	18		17		16		15		14		13		
7													
8	19		20		21		22		23		24		
9													
10	30		29		28		27		26		25		
11													
12	31		32		33		34		35		36		
13													

I, Bryan Boss, in a field survey on December 21, 1993, do hereby certify that under requirements of P.A. 74, Michigan P.A. of 1970, the corner points mentioned in lines 1 and 2 above were in conformance with regulations and rules therefore as required in the current manual of survey instructions of the United States Department of the Interior, Bureau of Land Management or by a decree of a Court of Law and/or that the corner points mentioned in lines 3, 4 and 5 above were in conformance with the rules of the Michigan Board of Land Surveyors or by a Decree of a Court of Law; established, re-established, monumented, re-monumented, recovered, found as expressed below:

NOTE: Not more than 4 corners, all in the same town and range, may be recorded on this certificate.

A. Description of original monument and accessories and/or subsequent restoration:

Surveyed by Dunning in 1919

SURVEY &  
REMONUMENTATION

JUL 30 1996

COMMISSION

B. Description of corner evidence found and/or method applied in restoring or reestablishing corner:

Found 3/8" Iron Rod 5 feet ± North of Centerline Strawberry Lake Road


C. Description of monument for corner and accessories established to perpetuate locating the position of the corner:

Set 1/2" x 30" Iron Rod and Raised with 1 1/4" x 6" I. Pipe with Brass Cap Marked Livingston Co. Monument Corner in Monument Box

S45°W 49.72' Spike N/Side 22' Hickory  
N25°W 41.80' Spike E/Side 13" Pine  
S60°E 82.99' Spike N/Side 7" Pine  
South 5' ± Centerline Strawberry Lk. Road.

Approved by Livingston Co. Monumentation Peer Group on September 29, 1992

Signed by [Signature]  
Surveyor's Michigan License No. 29238

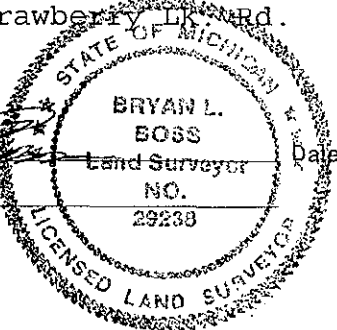

December 28, 1993