

FILED

DEC 28 4 17 PM '93

NANCY HAVILAND
REGISTER OF DEEDS
LIVINGSTON COUNTY, MI
48843

LAND CORNER RECORDATION CERTIFICATE
Filing Requirement of Act 74, Mich. P.A. 1970

For corners in

Livingston Located In: Corner Code #
(County)

1. Public Land Survey T 2N R 6E K-13
T _____ R _____
T _____ R _____
T _____ R _____

2. Property Controlling S _____ T _____ R _____
in Section S _____ T _____ R _____

3. Miscellaneous S _____ T _____ R _____
Property in Sec. S _____ T _____ R _____

4. Lot No. _____, Recorded Plat _____

5. Private Claims _____

L.S.C. #146m
Register of Deeds Stamp & File Number

I, Bryan Boss, in a field survey on December 20, 1993, do hereby certify that under requirements of P.A. 74, Michigan P.A. of 1970, the corner points mentioned in lines 1 and 2 above were in conformance with regulations and rules therefore as required in the current manual of survey instructions of the United States Department of the Interior, Bureau of Land Management or by a decree of a Court of Law and/or that the corner points mentioned in lines 3, 4 and 5 above were in conformance with the rules of the Michigan Board of Land Surveyors or by a Decree of a Court of Law; established, re-established, monumented, re-monumented, recovered, found as expressed below:

NOTE: Not more than 4 corners, all in the same town and range, may be recorded on this certificate.

A. Description of original monument and accessories and/or subsequent restoration:

- W. Oak 6 in. Dia. S9°E 6 Lks
- W. Oak 6 in. Dia. N9°W 5 Lks

	A	B	C	D	E	F	G	H	I	J	K	L	M
2	6	5	4	3	2	1							
3													
4	7	8	9	10	11	12							
5													
6	18	17	16	15	14	13							
7													
8	19	20	21	22	23	24							
9													
10	30	29	28	27	26	25							
11													
12	31	32	33	34	35	36							
13													

SURVEY &
REMONUMENTATION

1993

COMMISSION

B. Description of corner evidence found and/or method applied in restoring or reestablishing corner:

Reestablished Corner from Survey Notes by Herman Schultz Sept/Oct. 1944 and Maurice Baldwin 1951 Both were Huron-Clinton Metropolitan Authority Surveyors. Kensington Park Boundary


C. Description of monument for corner and accessories established to perpetuate locating the position of the corner:

Set 1/2" x 30" Iron Rod and Raised with 1 1/4" x 6" I. Pipe with Brass Cap Marked Livingston Co. Monument Corner in Monument Box

- E-NE'ly 98.90' Spike Power Pole
- E-SE'ly 96.73' Spike Power Pole
- North 51.00 2" Steel Post SE Cor. Cemetery
- W-NW'ly 60.94' Spike 12" Maple
- South 10.9' South Edge of Pavement

Approved by Livingston Co. Monumentation Peer Group on September 29, 1993

Signed by [Signature]
Surveyor's Michigan License No. 29238

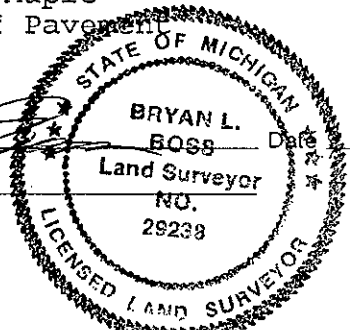

December 28, 1993