

"FILED"

DEC 28 4 17 PM '93

NANCY HAVILAND  
REGISTER OF DEEDS  
LIVINGSTON COUNTY, MI  
48843

LAND CORNER RECORDATION CERTIFICATE  
Filing Requirement of Act 74, Mich. P.A. 1970

For corners in

Livingston Located In: Corner Code L-9  
(County)

1. Public Land Survey	T <u>2N</u> R <u>6E</u>	<u>L-9</u>
	T _____ R _____	_____
	T _____ R _____	_____
	T _____ R _____	_____
2. Property Controlling in Section	S _____ T _____ R _____	_____
	S _____ T _____ R _____	_____
3. Miscellaneous Property in Sec.	S _____ T _____ R _____	_____
	S _____ T _____ R _____	_____

4. Lot No. \_\_\_\_\_, Recorded Plat \_\_\_\_\_

5. Private Claims \_\_\_\_\_

L.S.C. #145m

Register of Deeds Stamp & File Number

I, Bryan Boss, in a field survey on December 20, 1993, do hereby certify that under requirements of P.A. 74, Michigan P.A. of 1970, the corner points mentioned in lines 1 and 2 above were in conformance with regulations and rules therefore as required in the current manual of survey instructions of the United States Department of the Interior, Bureau of Land Management or by a decree of a Court of Law and/or that the corner points mentioned in lines 3, 4 and 5 above were in conformance with the rules of the Michigan Board of Land Surveyors or by a Decree of a Court of Law; established, re-established, monumented, re-monumented, recovered, found as expressed below:

NOTE: Not more than 4 corners, all in the same town and range, may be recorded on this certificate.

A. Description of original monument and accessories and/or subsequent restoration:

- W. Oak 14 in. Dia. N40°E 74 Lks
- W. Oak 12 in. Dia. S41°W 72 Lks
- 1/2" x 16" Bolt Set by Cole 3-12-58

B. Description of corner evidence found and/or method applied in restoring or reestablishing corner:


- Found 1/4" Iron Rod 5-6-93 Centerline Buno Road
- Kobane and Ross Found Rod 2-8-90
- Donald King Found Iron 11-16-89
- Finney & Kostecke Found 1/4" Iron Rod 7-23-73

C. Description of monument for corner and accessories established to perpetuate locating the position of the corner:

- Reset with 1 1/4" x 36" Breakaway Iron Pipe with Livingston Co. Brass Cap on Top.
- N15°W 53.14' Spike E/Side 12" Oak
- N15°E 50.18' Spike S/Side Twin Cherry
- South 41.18 Spike W/Side 24" Cherry
- S45°W 52.55' Spike E/Side 24" Oak
- S10°E 41.32' Spike E/Side 10" Ash

Approved by Livingston Co.  
Monumentation Peer Group  
on September 29, 1993

Signed by \_\_\_\_\_  
Surveyor's Michigan License No. 29238

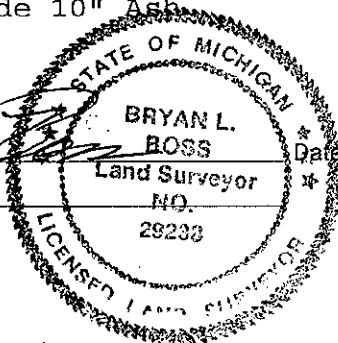

December 28, 1993

	A	B	C	D	E	F	G	H	I	J	K	L	M
2	6	5	4	3	2	1							
3													
4	7	8	9	10	11	12							
5													
6	18	17	16	15	14	13							
7													
8	19	20	21	22	23	24							
9													
10	30	29	28	27	26	25							
11													
12	31	32	33	34	35	36							
13													

SURVEY &  
REMONUMENTATION  
1993  
COMMISSION

SUMMARY  
L-9

North 1/4 Corner, Section 25, T1N-R5E, Hamburg Township,  
Livingston County, Michigan.


Found 1/2" I.O. pipe in monument box on centerline of  
Hamburg Road. Clean sweep of area revealed no other  
corners. This area is also open for G.P.S.

This dossier contains evidence that seven (7) surveyors have  
utilized this corner. All, with the exception of surveyor  
number 3, concur with the present location, see pages 6 and  
7.

Conclusion:

We conclude that the 1/2" pipe in cased in a monument box is  
the accepted corner.

HAML-9S

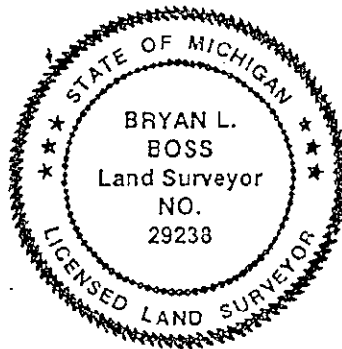

*Bryan L. Boss*