

1993

COMMISSION

LAND CORNER RECORDATION CERTIFICATE
Filing Requirement of Act 74, Mich. P.A. 1970

FILED

DEC 28 4 17 PM '93

NANCY HAVILAND
REGISTER OF DEEDS
LIVINGSTON COUNTY, MI
48843

For corners in

<u>Livingston</u> (County)	Located In:	Corner Code #
1. Public Land Survey	T <u>2N</u> R <u>6E</u>	<u>L-10</u>
	T _____ R _____	_____
	T _____ R _____	_____
	T _____ R _____	_____
2. Property Controlling in Section	S _____ T _____ R _____	_____
	S _____ T _____ R _____	_____
3. Miscellaneous Property in Sec.	S _____ T _____ R _____	_____
	S _____ T _____ R _____	_____

L.S.C. #142m
Register of Deeds Stamp & File Number

- 4. Lot No. _____, Recorded Plat _____
- 5. Private Claims _____

A	B	C	D	E	F	G	H	I	J	K	L	M
2	6	5	4	3	2	1						
3												
4	7	8	9	10	11	12						
5												
6	18	17	16	15	14	13						
7												
8	19	20	21	22	23	24						
9												
10	30	29	28	27	26	25						
11												
12	31	32	33	34	35	36						
13												

I, Bryan Boss, in a field survey on December 20, 1993, do hereby certify that under requirements of P.A. 74, Michigan P.A. of 1970, the corner points mentioned in lines 1 and 2 above were in conformance with regulations and rules therefore as required in the current manual of survey instructions of the United States Department of the Interior, Bureau of Land Management or by a decree of a Court of Law and/or that the corner points mentioned in lines 3, 4 and 5 above were in conformance with the rules of the Michigan Board of Land Surveyors or by a Decree of a Court of Law; established, re-established, monumented, re-monumented, recovered, found as expressed below:

NOTE: Not more than 4 corners, all in the same town and range, may be recorded on this certificate.

A. Description of original monument and accessories and/or subsequent restoration:

1/2" Iron Found Boss Engineering Co. Survey as Recorded in L. 904, Pg. 272, Livingston Co. Records.

B. Description of corner evidence found and/or method applied in restoring or reestablishing corner:

Found 1/2" Iron Rod 2' ± South of Centerline Spencer Road


C. Description of monument for corner and accessories established to perpetuate locating the position of the corner:

Reset with 1 1/4" x 36" Breakaway Iron Pipe with Livingston Co. Brass Cap on Top

- S53°E 37.84' Spike NE/Side 18" Oak
- S40°W 28.53' Spike NW/Side 12" Walnut
- South 30.89' Spike E/Side 34" Oak
- N40°W 42.85' Spike SW/Side 10" Cherry

Approved by Livingston Co. Monumentation Peer Group
September 15, 1993

Signed by _____
Surveyor's Michigan License No. 29238

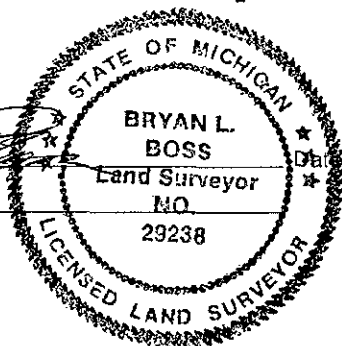

December 28, 1993