

LAND CORNER RECORDATION CERTIFICATE
Filing Requirement of Act 74, Mich. P.A. 1970

For corners in

_____ Livingston _____ Located In: _____ Corner Code # _____
(County)

1. Public Land Survey	T	<u>2N</u>	R	<u>6E</u>	<u>L-13</u>
	T	_____	R	_____	_____
	T	_____	R	_____	_____
	T	_____	R	_____	_____
2. Property Controlling in Section	S	_____	T	_____	R
	S	_____	T	_____	R
3. Miscellaneous Property in Sec.	S	_____	T	_____	R
	S	_____	T	_____	R

4. Lot No. _____, Recorded Plat _____

5. Private Claims _____

FILED
DEC 28 4 17 PM '93
NANCY HAVILAND
REGISTER OF DEEDS
LIVINGSTON COUNTY, MI
48843

L.S.C. #135m
 Register of Deeds Stamp & File Number

	A	B	C	D	E	F	G	H	I	J	K	L	M
2	6		5		4		3		2		1		
3													
4	7		8		9		10		11		12		
5													
6	18		17		16		15		14		13		
7													
8	19		20		21		22		23		24		
9													
10	30		29		28		27		26		25		
11													
12	31		32		33		34		35		36		
13													

I, Bryan Boss, in a field survey on December 20, 1993, do hereby certify that under requirements of P.A. 74, Michigan P.A. of 1970, the corner points mentioned in lines 1 and 2 above were in conformance with regulations and rules therefore as required in the current manual of survey instructions of the United States Department of the Interior, Bureau of Land Management or by a decree of a Court of Law and/or that the corner points mentioned in lines 3, 4 and 5 above were in conformance with the rules of the Michigan Board of Land Surveyors or by a Decree of a Court of Law; established, re-established, monumented, re-monumented, recovered, found as expressed below:

NOTE: Not more than 4 corners, all in the same town and range, may be recorded on this certificate.

A. Description of original monument and accessories and/or subsequent restoration:

R. Oak 6 in. Dia. N74°E 26 Lks.
 W. Oak 18 in. Dia. S20°W 80 Lks.

SURVEY &
 MONUMENTATION
 1993
 COMMISSION

B. Description of corner evidence found and/or method applied in restoring or reestablishing corner:

Reestablished Corner from Survey Notes by Herman Schultz Huron-Clinton Metropolitan Authority Surveyor, Kensington Park Sept. Oct. 1944.

C. Description of monument for corner and accessories established to perpetuate locating the position of the corner:


Set 1 1/4" x 36" Iron Pipe with Brass Cap
 (Livingston County Monument Corner)

S50°W 119.23' Spike W/Side Power Pole
 S07°E 98.66' Spike W/Side Twin 6" Box Elder
 S60°E 230.03' Spike E/Side Power Pole

Approved by Livingston Co. Monumentation Peer Group on September 15, 1993

Signed by _____

Surveyor's Michigan License No. 29238

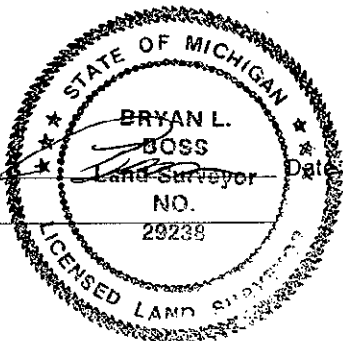

December 28, 1993

