

SURVEY & REMONUMENTATION

FEB 24 1998

SECTION

LAND CORNER RECORDATION CERTIFICATE
Filing Requirement of Act 74, Mich. P.A. 1970

FILED

9-

1997 NOV 25 A 11:12

NANCY HAVILAND
 REGISTER OF DEEDS
 LIVINGSTON COUNTY, MI.
 48843

L.S.C.#815m
 Register of Deeds Stamp & File Number

For corners in
Livingston (County) Located In: Brighton Twp. Corner Code M-5

1. Public Land Survey T 2N R 6E M-5
 T _____ R _____
 T _____ R _____
 T _____ R _____

2. Property Controlling S _____ T _____ R _____
 in Section S _____ T _____ R _____

3. Miscellaneous S _____ T _____ R _____
 Property in Sec. S _____ T _____ R _____

4. Lot No. _____, Recorded Plat _____

5. Private Claims _____

	A	B	C	D	E	F	G	H	I	J	K	L	M
2	6	5	4	3	2	1							
3													
4	7	8	9	10	11	12							
5													
6	18	17	16	15	14	13							
7													
8	19	20	21	22	23	24							
9													
10	30	29	28	27	26	25							
11													
12	31	32	33	34	35	36							
13													

I, Bryan L. Boss, in a field survey on November 4, 1997, do hereby certify that under requirements of P.A. 74, Michigan P.A. of 1970, the corner points mentioned in lines 1 and 2 above were in conformance with regulations and rules therefore as required in the current manual of survey instructions of the United States Department of the Interior, Bureau of Land Management or by a decree of a Court of Law and/or that the corner points mentioned in lines 3, 4 and 5 above were in conformance with the rules of the Michigan Board of Land Surveyors or by a Decree of a Court of Law; established, re-established, monumented, re-monumented, recovered, found as expressed below:

NOTE: Not more than 4 corners, all in the same town and range, may be recorded on this certificate.

- A. Description of original monument and accessories and/or subsequent restoration:
- White Oak 36" N33°W 2.25'
 - White Oak 5" N89½°E .38' M.W.B. 1880

B. Description of corner evidence found and/or method applied in restoring or reestablishing corner:


Found axle shaft spline 6 feet South of centerline old asphalt road Easterly and 3 feet East of North-South Gravel Access Road.

P.A. 345 1990, APPROVED BY LIVINGSTON COUNTY
 REFER GROUP ON 9-17-97 CO. REP JED

C. Description of monument for corner and accessories established to perpetuate locating the position of the corner:

Set 1½"X30" pipe with a 6 inch breakoff and brass cap stamped "Livingston County Monumentation Corner" in monument box 4 feet South and 3 feet East of intersection.

- N10°E 32.97' Nail & Tag West side 26" Oak
- S25°W 158.30' Nail & Tag West side Utility Pole
- N60°W 130.61' Southwest corner of Barn
- N20°W 48.48' Nail & Tag East side Utility Pole

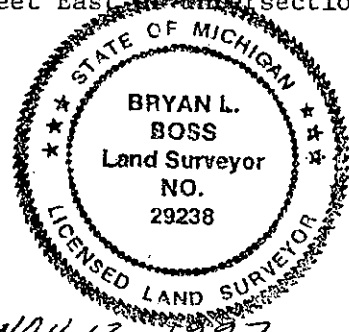

Signed by Bryan L. Boss Date NOV. 12, 1997
 Surveyor's Michigan License No. _____

**SUMMARY
M-5**

Northeast Corner, Section 13, Brighton Township.

Corner originally set in 1816 by Alex Holmes. G.L.O. Map of Milford Township records 33 links fall in distance North of M-5. In 1880, Miles Bullock witnessed 5" white oak N 89°E .38CH. (25.08ft).


Found axle shaft spline six feet ± South of Centerline abandoned asphalt road and three feet ± East of gravel surface access road.

This corner is open for G.P.S.

The Axle shaft spline is 1.2 feet South of the Corner per Warner survey of 1954.

We recommend setting M-5 to match Warner survey.

BRISM-5

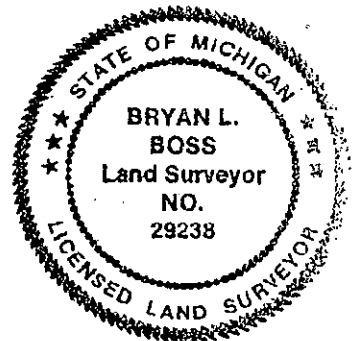

Bryan L. Boss