

FEB 24 1998

SECTION

LAND CORNER RECORDATION CERTIFICATE
Filing Requirement of Act 74, Mich. P.A. 1970

9
FILED

1997 NOV 25 A 11: 12

NANCY HAVILAND
REGISTER OF DEEDS
LIVINGSTON COUNTY, MI.
48843

L.S.C.#816m

Register of Deeds Stamp & File Number

For corners in

LIVINGSTON	Located In:	Corner Code //
	BRIGHTON TWP.	
1. Public Land Survey	T 2N R 6E	M-6
	T R	
	T R	
	T R	
2. Property Controlling in Section	S T R	
	S T R	
3. Miscellaneous Property in Sec.	S T R	
	S T R	

- 4. Lot No. _____, Recorded Plat _____
- 5. Private Claims _____

A	B	C	D	E	F	G	H	I	J	K	L	M
2	6	5	4	3	2	1						
3												
4	7	8	9	10	11	12						
5												
6	18	17	16	15	14	13						
7												
8	19	20	21	22	23	24						
9												
10	30	29	28	27	26	25						
11												
12	31	32	33	34	35	36						
13												

I, BRYAN L. BOSS, in a field survey on SEPTEMBER 22, 19 97, do hereby certify that under requirements of P.A. 74, Michigan P.A. of 1970, the corner points mentioned in lines 1 and 2 above were in conformance with regulations and rules therofore as required in the current manual of survey instructions of the United States Department of the Interior, Bureau of Land Management or by a decree of a Court of Law and/or that the corner points mentioned in lines 3, 4 and 5 above were in conformance with the rules of the Michigan Board of Land Surveyors or by a Decree of a Court of Law; established, re-established, monumented, re-monumented, recovered, found as expressed below:


NOTE: Not more than 4 corners, all in the same town and range, may be recorded on this certificate.

A. Description of original monument and accessories and/or subsequent restoration:
WHITE OAK 30" S 38 E 25 LINKS
HICKORY 12" N 13 W 29 LINKS
WALNUT 3" S 12 1/4 W 1.63 CHAINS
BEING .76 1/2 NORTH OF STONE SET BY NICKELSON (50.49 FEET)

B. Description of corner evidence found and/or method applied in restoring or reestablishing corner:
FOUND 1 1/2" INCH IRON IN EMPLOYEE PARKING LOT WITHIN THE CONFINES OF THE PROVING GROUNDS.
THE IRON HAD BEEN SET IN A SQUARE MONUMENT BOX 63 FEET NORTH OF AN ISLAND IN PAVED LOT.

P.A. 345 1990, APPROVED BY LIVINGSTON COUNTY
PEER GROUP ON 9-17-97 CO. REP JED

C. Description of monument for corner and accessories established to perpetuate locating the position of the corner:
SET BRASS CAP OVER 1 1/2" PIPE IN MONUMENT BOX
STAMPED LIVINGSTON COUNTY MONUMENTATION CORNER
580°E 115.22' CENTER OF LIGHT POLE.
SOUTH 63.29' 1" IRON IN MONUMENT BOX
S50°W 46.63 CENTER OF LIGHT POLE
N30°W 158.30 CENTER OF LIGHT POLE

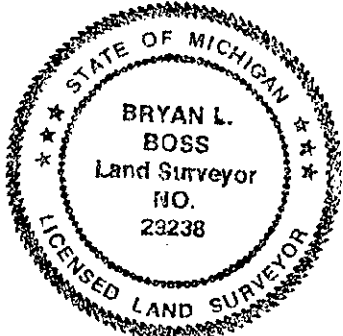

Signed by [Signature] Date NOV. 11, 1997
Surveyor's Michigan License No. 29238

**SUMMARY
M-6**

East 1/4 Corner, Section 13, T2N-R6E, Brighton Township.

The Township line was surveyed in 1816 by Alex Holmes and a post set at 40 chains. In 1880, Miles Bullock witnessed corner and also found stone 76 1/2 Links (50.49 ft.) South set by Nickolson. G.L.O. Records 86.29 feet and in 1954 Warner and Warner measured 68.55 feet Northerly to the West 1/4 Corner of Section 18, Milford Township.

Warner & Warner survey on June 2, 1954, Traversed Milford Proving Grounds and also set coordinates on found Section Corners and 1/4 Corners. Along the Township line.

The Midwestern Consulting survey dated 2-16-86 measurements North & South along town line agrees with Warner survey. (See distance sheet on page 6, this dossier).

On June of 1997 and on Sept. 15, 1997, Boss Engineering utilized G.P.S. in determining the location of this corner. A 1 1/2 " iron was found in a Square Mon. Box. This iron is in a large employee parking lot within the confines of the Proving Grounds.

A distance of 2706.20 feet was measured from the approved M-7 Corner to a found 1 1/2" iron. Note Warner measured 2706.91 feet from M-7 to M-6.

The West 1/4 Corner of Section 18, Milford Township falls 68.55 feet North of M-6 per Warner survey. No point was found in this area. (Note Boss field notes on page 12 of dossier shows a 1" iron in a round Mon Box was found 63.29 feet SOUTH of the point at M-6, This appears to be the non-dimensioned point on the Warner survey South of M-6.

The area is open for G.P.S.

We recommend accepting East 1/4 Corner, Section 13, as found by Warner Warner Survey.

Sumbm-6



Bryan L. Boss