

**SURVEY &
REMONUMENTATION**

FILED
Nov 16 11 04 AM '94

LAND CORNER RECORDATION CERTIFICATE
APR 28 1995 Filing Requirement of Act 74, Mich. P.A. 1970

NANCY HAVILAND
REGISTER OF DEEDS
LIVINGSTON COUNTY, MI
48843

For corners in

Livingston **COMMISSION** Located In: Corner Code #

1. Public Land Survey	T	<u>2N</u>	R	<u>6E</u>	<u>M-7</u>
	T	_____	R	_____	_____
	T	_____	R	_____	_____
	T	_____	R	_____	_____
2. Property Controlling in Section	S	_____	T	_____	_____
	S	_____	T	_____	_____
3. Miscellaneous Property in Sec.	S	_____	T	_____	_____
	S	_____	T	_____	_____

L.S.C. #323m
Register of Deeds Stamp & File Number

4. Lot No. _____, Recorded Plat _____
5. Private Claims _____

	A	B	C	D	E	F	G	H	I	J	K	L	M
2	6		5		4		3		2		1		
3													
4	7		8		9		10		11		12		
5													
6	18		17		16		15		14		13		
7													
8	19		20		21		22		23		24		
9													
10	30		29		28		27		26		25		
11													
12	31		32		33		34		35		36		
13													

I, Bryan Boss, in a field survey on 10-26, 19 94, do hereby certify that under requirements of P.A. 74, Michigan P.A. of 1970, the corner points mentioned in lines 1 and 2 above were in conformance with regulations and rules therefore as required in the current manual of survey instructions of the United States Department of the Interior, Bureau of Land Management or by a decree of a Court of Law and/or that the corner points mentioned in lines 3, 4 and 5 above were in conformance with the rules of the Michigan Board of Land Surveyors or by a Decree of a Court of Law; established, re-established, monumented, re-monumented, recovered, found as expressed below:

NOTE: Not more than 4 corners, all in the same town and range, may be recorded on this certificate.

A. Description of original monument and accessories and/or subsequent restoration:

White Oak 5" S 5 E 54 Links
Yellow Oak 16" N 14 E 1.88½

ADDITIONAL HISTORICAL DATA ON BACK OF SHEET


B. Description of corner evidence found and/or method applied in restoring or reestablishing corner:

Found 1/2" inch capped iron H.K.K. #17623. M-7 set by Kennedy Surveying in 1991. Township jog North to monument box at centerline of Stobart Road is 144.91 feet, the same as 1954 survey by Warner & Warner. A 1/2 section breakdown was performed by Kennedy.

C. Description of monument for corner and accessories established to perpetuate locating the position of the corner:

Set 1½" x 30" iron pipe and raised with 1½" x 6" iron pipe with brass cap marked Livingston County Monument corner.

- N20°E 42.10' N/T NW/S 8" Maple
- N50°E 32.48' N/T NW/S 24" Maple
- West 38.64' N/T N/S 30" Oak
- S35°E 64.73' N/T W/S 30" Oak
- North 144.91' Mon.Box C/L Stobart Rd

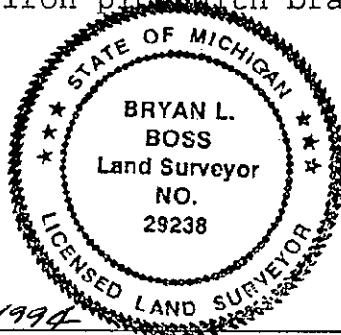

Signed by [Signature] Date 11-10-1994
Surveyor's Michigan License No. 29238

T2N-R6E M-7 Pg. 1

BE BOSS ENGINEERING **ENGINEERS & SURVEYORS**

SUMMARY
M-7


NORTHEAST CORNER, SECTION 24, T2N-R6E BRIGHTON TOWNSHIP, LIVINGSTON COUNTY, MICHIGAN.

Found 1/2" inch iron rod (capped H.K.K. #17623) 0.20' feet below surface and 2 feet ± West of Centerline Labadie Road. Also found monument bearing North 144.91' feet at Centerline Stobart Road and Labadie Road (Northwest Corner of Section 19, Milford Township. Measured to Witnesses found. Found 3 of 3 Kennedy Surveying Witnesses page 15 and they checked. 3 of Warner & Warner Witnesses gone, pages 12 and 13.

Distance from Northeast Corner of Section 24 to the North 1/4 Corner of said Section is 2672.00' feet Miles Bullock Survey, page 9 of this Dossier 2669.58' feet Warner & Warner Survey pages 10, 11, 12 this Dossier 2669.79' feet Kennedy Survey page 14. Labadie Road is in a deep cut section with high banks and overhanging branches. It will be very difficult for G.P.S..

Conclusion: M-7 recently set by Kennedy Surveying in 1991. Witnesses on page 15 prove that it is obvious a 1/2 Section breakdown was performed. Distance to North 1/4 Corner by 3 Surveyors are consistent and the Township jog of 144.91 is the same today as it was in 1954.

We recommend acceptance of the 1/2" inch capped iron as the Northeast Corner of Section 24.

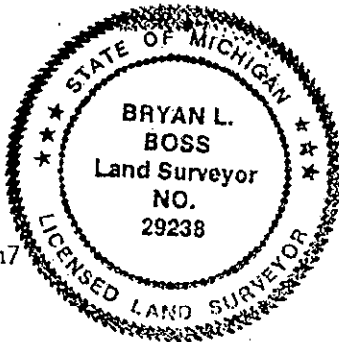

A handwritten signature in black ink, appearing to read "Bryan L. Boss", written over the right side of the professional seal.

file: summm7