

FILED

DEC 28 4 17 PM '93

NANCY HAVILAND  
REGISTER OF DEEDS  
LIVINGSTON COUNTY, MI  
48843

LAND CORNER RECORDATION CERTIFICATE  
Filing Requirement of Act 74, Mich. P.A. 1970

For corners in

Livingston  
(County)

Located In:

Corner Code #

- |                                    |   |       |    |       |
|------------------------------------|---|-------|----|-------|
|                                    |   | 2N    | 6E | M-10  |
| 1. Public Land Survey              | T | _____ | R  | _____ |
|                                    | T | _____ | R  | _____ |
|                                    | T | _____ | R  | _____ |
|                                    | T | _____ | R  | _____ |
| 2. Property Controlling in Section | S | _____ | T  | _____ |
|                                    | S | _____ | T  | _____ |
| 3. Miscellaneous Property in Sec.  | S | _____ | T  | _____ |
|                                    | S | _____ | T  | _____ |
4. Lot No. \_\_\_\_\_, Recorded Plat \_\_\_\_\_
5. Private Claims \_\_\_\_\_

L.S.C. #136m  
Register of Deeds Stamp & File Number

I, Bryan Boss, in a field survey on December 20, 1993, do hereby certify that under requirements of P.A. 74, Michigan P.A. of 1970, the corner points mentioned in lines 1 and 2 above were in conformance with regulations and rules therefore as required in the current manual of survey instructions of the United States Department of the Interior, Bureau of Land Management or by a decree of a Court of Law and/or that the corner points mentioned in lines 3, 4 and 5 above were in conformance with the rules of the Michigan Board of Land Surveyors or by a Decree of a Court of Law; established, re-established, monumented, re-monumented, recovered, found as expressed below:

NOTE: Not more than 4 corners, all in the same town and range, may be recorded on this certificate.

A. Description of original monument and accessories and/or subsequent restoration:

1/2" x 6" Timber Spike Set by Cole 2-21-58

B. Description of corner evidence found and/or method applied in restoring or reestablishing corner:

Found 1/2" Iron Rod


C. Description of monument for corner and accessories established to perpetuate locating the position of the corner:

Reset with 1 1/4" x 36" Breakaway Iron Pipe with Livingston Co. Brass Cap on Top.

N35°W 42.44' Spike E/Side 18" Walnut  
S80°W 52.07' Spike N/Side 30" Oak  
S70°E 24.59' Spike S/Side 18" Maple  
(Quad Maple Spike is in NW Tree)  
N45°E 31.17' Spike W/Side 18" Oak

Approved by Livingston Co.  
Monumentation Peer Group  
on September 15, 1993

Signed by \_\_\_\_\_  
Surveyor's Michigan License No. 29238

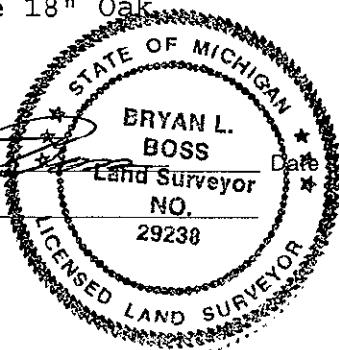

December 28, 1993

A	B	C	D	E	F	G	H	I	J	K	L	M
2	6	5	4	3	2	1						
3												
4	7	8	9	10	11	12						
5												
6	13	17	16	15	14	13						
7												
8	19	20	21	22	23	24						
9												
10	30	29	28	27	26	25						
11												
12	31	32	33	34	35	36						
13												

SURVEY &  
REMONUMENTATION  
1993  
COMMISSION