

FILED

DEC 28 4 17 PM '93

LAND CORNER RECORDATION CERTIFICATE  
Filing Requirement of Act 74, Mich. P.A. 1970

NANCY HAVILAND  
REGISTER OF DEEDS  
LIVINGSTON COUNTY, MI  
48843

For corners in

Livingston (County) Located In: Corner Code #/

1. Public Land Survey T 2N R 6E M-12  
 T \_\_\_\_\_ R \_\_\_\_\_  
 T \_\_\_\_\_ R \_\_\_\_\_  
 T \_\_\_\_\_ R \_\_\_\_\_

2. Property Controlling S \_\_\_\_\_ T \_\_\_\_\_ R \_\_\_\_\_  
 in Section S \_\_\_\_\_ T \_\_\_\_\_ R \_\_\_\_\_

3. Miscellaneous S \_\_\_\_\_ T \_\_\_\_\_ R \_\_\_\_\_  
 Property in Sec. S \_\_\_\_\_ T \_\_\_\_\_ R \_\_\_\_\_

4. Lot No. \_\_\_\_\_, Recorded Plat \_\_\_\_\_

5. Private Claims \_\_\_\_\_

L.S.C. #134m  
Register of Deeds Stamp & File Number

I, Bryan Boss, in a field survey on December 20, 1993, do hereby certify that under requirements of P.A. 74, Michigan P.A. of 1970, the corner points mentioned in lines 1 and 2 above were in conformance with regulations and rules therefore as required in the current manual of survey instructions of the United States Department of the Interior, Bureau of Land Management or by a decree of a Court of Law and/or that the corner points mentioned in lines 3, 4 and 5 above were in conformance with the rules of the Michigan Board of Land Surveyors or by a Decree of a Court of Law; established, re-established, monumented, re-monumented, recovered, found as expressed below:

	A	B	C	D	E	F	G	H	I	J	K	L	M
2	6	5	4	3	2	1							
3													
4	7	8	9	10	11	12							
5													
6	18	17	16	15	14	13							
7													
8	19	20	21	22	23	24							
9													
10	30	29	28	27	26	25							
11													
12	31	32	33	34	35	36							
13													

NOTE: Not more than 4 corners, all in the same town and range, may be recorded on this certificate.

A. Description of original monument and accessories and/or subsequent restoration:

GLO Witness  
B. Oak 5 in. Dia. S33°E 19 Lks

SURVEY &  
REMONUMENTATION  
1993  
COMMISSION

B. Description of corner evidence found and/or method applied in restoring or reestablishing corner:

Reestablished Corner from Survey Notes by Herman Schultz  
Huron-Clinton Metropolitan Authority Surveyor  
Kensington Park Sept./Oct. 1944.


C. Description of monument for corner and accessories established to perpetuate locating the position of the corner:

Set Monument Box Centerline of Road.  
Set 1/2" x 30" Iron Rod and Raised with  
1 1/4" x 6" I. Pipe with Brass Cap Marked  
Livingston Co. Monument Corner

N40°W 36.01 Spike W/Side 8" Willow  
N40°E 40.62' Spike E/Side 16" Poplar  
S30°E 57.93 Spike E/Side 22" Poplar  
S60°W 32.90' Spike N/Side 10" Willow

Approved by Livingston Co.  
Monumentation Peer Group  
on Sept. 15, 1993

Signed by Bryan L. Boss  
Surveyor's Michigan License No. 29238

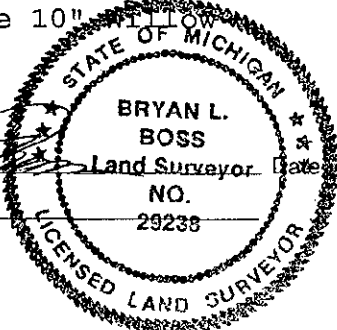

December 18, 1993