

**SURVEY &  
REMONUMENTATION**

JUN 01 1998

**FILED**

**SECTION**

**LAND CORNER RECORDATION CERTIFICATE  
Filing Requirement of Act 74, Mich. P.A. 1970**

1998 MAY 29 P 1:44

For corners in

LIVINGSTON  
(County)

Located in  
BRIGHTON TWP.

Corner Code 11

9-

NANCY HAVILAND  
REGISTER OF DEEDS  
LIVINGSTON COUNTY, MI.  
48843

|                                    |   |    |   |    |      |
|------------------------------------|---|----|---|----|------|
| 1. Public Land Survey              | I | R  |   |    |      |
|                                    | I | R  |   |    |      |
|                                    | T | R  |   |    |      |
|                                    | I | R  |   |    |      |
| 2. Property Controlling in Section | S | T  | R |    |      |
|                                    | S | T  | R |    |      |
| 3. Miscellaneous Property in Sec.  | S | 01 | T | 2N | R 6E |
|                                    | S | T  | R |    |      |

*Def. H2*

L.S.C. #840m

(See L.S.C. #828m)

Register of Deeds Stamp & File Number

- 4. Lot No. , Recorded Plat
- 5. Private Claims

I, **BRYAN L. BOSS**, in a field survey on **SEPTEMBER 22,** 19**97** do hereby certify that under requirements of P.A. 74, Michigan P.A. of 1970, the corner points mentioned in lines 1 and 2 above were in conformance with regulations and rules therefore as required in the current manual of survey instructions of the United States Department of the Interior, Bureau of Land Management or by a decree of a Court of Law and/or that the corner points mentioned in lines 3, 4 and 5 above were in conformance with the rules of the Michigan Board of Land Surveyors or by a Decree of a Court of Law, established, re established, monumented, re monumented, recovered, found as expressed below

**NOTE:** Not more than 4 corners, all in the same town and range, may be recorded on this certificate.

|    | A  | B | C  | D | E  | F | G  | H | I  | J | K  | L | M |
|----|----|---|----|---|----|---|----|---|----|---|----|---|---|
| 2  | 6  |   | 5  |   | 4  |   | 3  |   | 2  |   | 1  |   |   |
| 3  |    |   |    |   |    |   |    |   |    |   |    |   |   |
| 4  | 7  |   | 8  |   | 9  |   | 10 |   | 11 |   | 12 |   |   |
| 5  |    |   |    |   |    |   |    |   |    |   |    |   |   |
| 6  | 16 |   | 17 |   | 18 |   | 19 |   | 20 |   | 21 |   |   |
| 7  |    |   |    |   |    |   |    |   |    |   |    |   |   |
| 8  | 19 |   | 20 |   | 21 |   | 22 |   | 23 |   | 24 |   |   |
| 9  |    |   |    |   |    |   |    |   |    |   |    |   |   |
| 10 | 30 |   | 29 |   | 28 |   | 27 |   | 26 |   | 25 |   |   |
| 11 |    |   |    |   |    |   |    |   |    |   |    |   |   |
| 12 | 31 |   | 32 |   | 33 |   | 34 |   | 35 |   | 36 |   |   |
| 13 |    |   |    |   |    |   |    |   |    |   |    |   |   |

A Description of original monument and accessories and/or subsequent restoration

CLOSED ON THE EAST SIDE OF THE SWAMP COULD NEITHER SET THE 1/2 MILE NOR MILE POST. CONTINUED SOUTH 15 CHAINS ON THE SECOND MILE THEN TURNED WEST 14 CHAINS TO THE LINE.

B Description of corner evidence found and/or method applied in restoring or reestablishing corner

FOUND A POINTED SHAFT LEANING AT OLD DAMAGED FENCE CORNER. FENCES RUNNING NORTH-SOUTH & EAST.

C Description of monument for corner and accessories established to perpetuate locating the position of the corner

-002: of 1  
SET 1 1/4" X 36" PIPE WITH BRASS CAP STAMPED "LIVINGSTON COUNTY MONUMENTATION CORNER".  
N 35 E 15.45 NAIL & TAG NORTHWEST SIDE 10" CHERRY  
EAST 11.58 NAIL & TAG SOUTH SIDE 12" SASSAFRASS  
SOUTH 6.80 NAIL & TAG EAST SIDE 10" TWIN SASSAFRASS  
N 50 W 22.40 NAIL & TAG NORTHWEST SIDE 12" OAK



Signed by *Bryan L. Boss*

Date *May 20 1998*

Surveyor's Michigan License No. 29238

FORM APPROVED BY MICHIGAN STATE BOARD OF LAND SURVEYORS JAN 28 1971  
REVISED MAY 14 1975  
REVISED JAN 1983

PA. 345 1990, APPROVED BY LIVINGSTON COUNTY

PEER GROUP ON *9-17-97* CO. REP *JED*

**SUMMARY  
M-3**

**Southeast Corner, Section 1, Brighton Township.**


This Corner was not set by GLO.

The G.L.O. field notes record "could neither set the 1/2 mile nor mile post, continued 15 chains on the second mile, there turned West 14 chains to the line". (see page 5 of dossier for sketch of GLO measurements)

Found 1 inch pointed shaft in heavily wooded area. Difficult G.P.S. area. The corner was found 220 feet  $\pm$  West of test track road and 250 feet  $\pm$  South of ditch. The pointed shaft had been disturbed and bent at fence corner post with fence lines running North-South and Easterly.

Note on page 6 this dossier that G.P.S. was utilized by Boss Engineering. This point was found 0.69 feet south of the point as located on the Warner survey of 1954.

We recommend setting remonumentation corner 0.69 feet North of existing disturbed location to match the Warner survey of 1954.

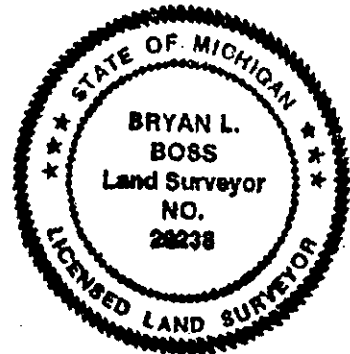

*Bryan L. Boss*