

SURVEY & REMONUMENTATION

FEB 26 2001

SECTION

LAND CORNER RECORDATION CERTIFICATE
Filing Requirement of Act 74, Mich. P.A. 1970

FILED

For corners in
LIVINGSTON
(County)

Located in: BRIGHTON Corner Code #

- | | | | |
|------------------------------------|-------------|-------------|------------|
| 1. Public Land Survey | T <u>2N</u> | R <u>6E</u> | <u>F-7</u> |
| | T _____ | R _____ | _____ |
| | T _____ | R _____ | _____ |
| | T _____ | R _____ | _____ |
| 2. Property Controlling in Section | S _____ | T _____ | R _____ |
| | S _____ | T _____ | R _____ |
| 3. Miscellaneous Property in Sec. | S _____ | T _____ | R _____ |
| | S _____ | T _____ | R _____ |


2000 OCT 19 A 10:31

NANCY HAVILAND
REGISTER OF DEEDS
LIVINGSTON COUNTY, MI.
48843

OK LSC #1300M
Register of Deeds Stamp and File Number

4. Lot No. _____, Recorded Plat _____
5. Private Claims _____

I, Bryan L. Boss, in a field survey on MARCH 23, 2000, do hereby certify that under requirements of P.A. 74, Michigan P.A. of 1970, the corner points mentioned in lines 1 and 2 above were in conformance with regulations and rules therefor as required in the current manual of survey instructions of the United States Department of the Interior, Bureau of Land Management or by a decree of a Court of Law and/or that the corner points mentioned in lines 3, 4 and 5 above were in conformance with the rules of the Michigan Board of Land Surveyors or by a Decree of a Court of Law; established, re-established, monumented, re-monumented, recovered, found as expressed below.

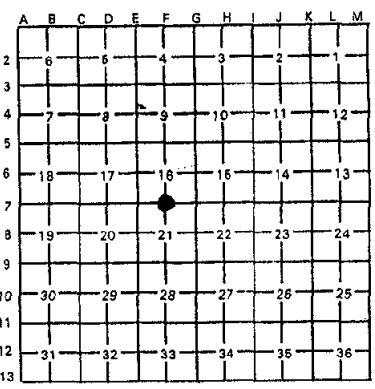


NOTE: Not more than 4 corners, all in the same town and range, may be recorded on this certificate.

- A. Description of original monument and accessories and/or subsequent restoration:
1823 BY S. SIBLEY, DEPUTY SURVEYOR
SET POST
B. OAK 7" S 89 1/2"W 16 LINKS
W. OAK 8" N 89° E 9 LINKS

- B. Description of corner evidence found and/or method applied in restoring or reestablishing corner:
FOUND PK NAIL IN CENTERLINE SKEMAN DRIVE

- C. Description of monument for corner and accessories established to perpetuate locating the position of the corner:
SET 1 1/4" X 12" STEEL PIPE AND BRASS CAP
STAMPED "LIVINGSTON COUNTY
REMONUMENTATION CORNER" ABOVE A
POINTED STONE IN A MONUMENT BOX
NORTH 33.15' SET REMON NAIL/TAG W/SIDE TWIN OAK S 5°W 56.93' SET REMON NAIL/TAG N/SIDE 32" OAK
N 80° E 121.91' SET REMON NAIL/TAG S/SIDE 30" WEST 83.10' SET REMON NAIL/TAG S/SIDE 20" OAK
CHERRY
S 60° E 74.61' SET REMON NAIL/TAG N/SIDE 30" OAK

PA. 348 1888, APPROVED BY LIVINGSTON COUNTY
PEER GROUP ON 3-15-2000, CO. REP JED

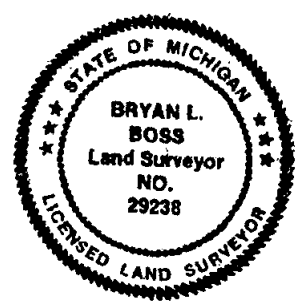

Signed by Bryan L. Boss Date Sept 5, 2000
Surveyor's Michigan License No. 29238